IREDELL COUNTY HEALTH DEPARTMENT

..ESVILLE 704-878-5305 paid 175.00 MOORESVILLE 704-664-5281

IMPROVEMENT PERMIT / AUTHORIZATION TO CONSTRUCT / OPERATION PERMIT / EXISTING SYSTEM INSPECTION

PERMIT# 92971 PIN# 4679022878 PT 4679-02-8472 DATE 12/11/00

OWNER OR CONTRACTOR BEECHWOOD PARTNERS / LEADER HOMES PHONE: Business 664-9050 Home

ADDRESS 225 ROLLING HILLS RD - MOORESVILLE - NC

LOCATION 801 N - TL TRIPLETT RD - TL MALLARDWOOD - ON RT

SUBDIVISION BEECHWOOD EST. BLOCK / SECTION LOT 6 LOT AREA .754C SITE CLASS. PS DESIGN FLOW 360GPD L.T.A.R. .30RD/FT²

Septic Tank: 1000 Gallons; STB 1012 Date 2-7-2000

Pump Tank: 1000 Gallons; PT 17 Date 8-21-2000

Pump Make: Hydromatic Model SK50AH Serial No. 51652-007

Nitrification Field: No Fields 1 Square Feet 1200 Linear Feet 400

No Lines 5@80' Trench Width 36" Max Trench Bottom Depth 36" Gravel Depth 12"

☑ New System ☐ Repair System Type: I, II, (III), IV, V, VI

System Description: PUMP CONVENTIONAL

Repair System Description: PUMP 25% REDUCTION

Maintenance Agreement Required: ☐ Yes ☑ No

☑ House/Mod. Home No. Bedrooms 3

☐ Mobile Home No. Bathrooms 2

☐ Business No. Employees

☐ Other

☐ Slab ☑ Crawl Space ☐ Basement w/plumbing ☐ Basement wo/plumbing


Water Supply: ☑ Individual ☐ Public ☐ Community

Comments:/Conditions:


Comments:/Conditions: Polylok filter installed at risers

LINES INSPECTED 1/4/2001. MD

INITIAL SITE SKETCH 1" = 50'

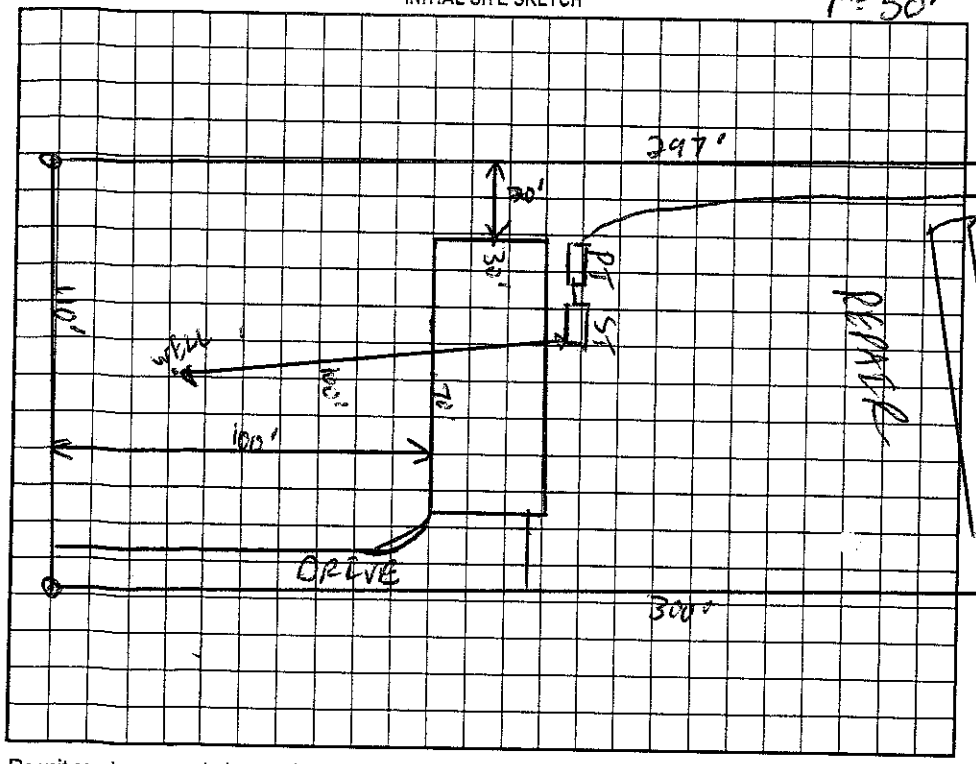

AS BUILT SKETCH

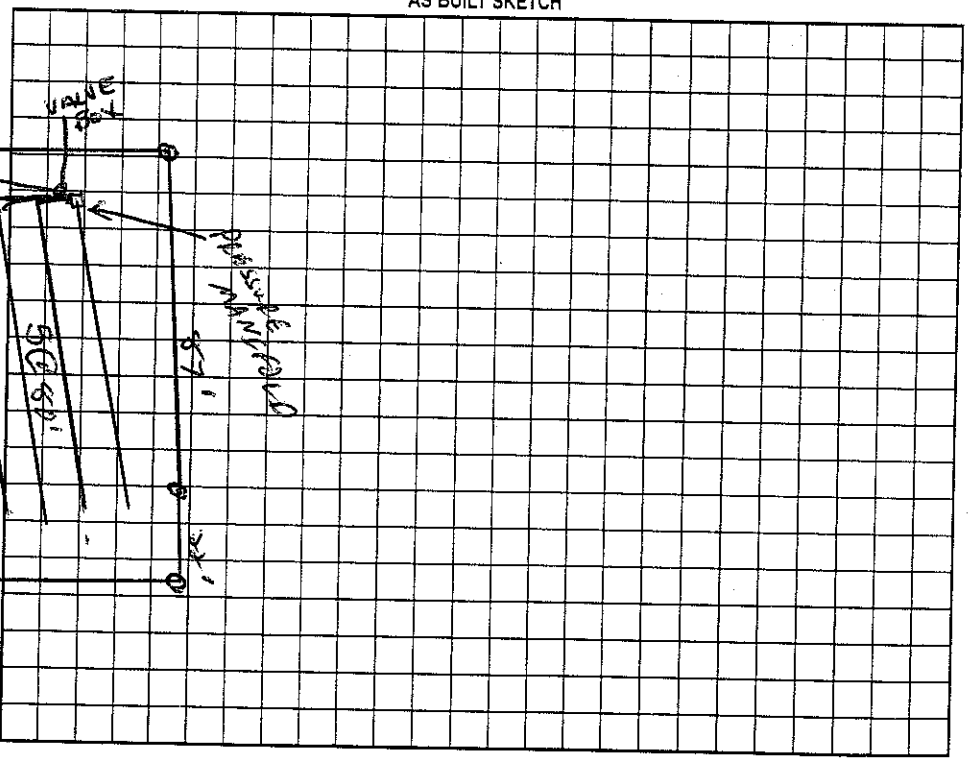

Permit can be suspended or revoked if any false information is supplied toward securing the permit/any unauthorized changes are made to the site/any unauthorized changes are made in the installation of the system. Improvement Permit with plat valid without expiration. Improvement Permit with site plan valid for sixty months. Authorization to Construct is valid for a period equal to that of Improvement Permit – not to exceed sixty months.

Signed: [signature] date 12/11/00

Improvement Permit by: [signature] date 12/11/00

Authorization to Construct by: [signature] date 12/11/00

Installed by: A-1 Backhoe

Operation Permit by: Wesley Sparks RS date 1/29/01

Existing System Inspection by: date

HEALTH DEPT. COPY: WHITE OWNER COPY (FINAL): YELLOW OWNER COPY (INITIAL): PINK