# IREDELL COUNTY HEALTH DEPARTMENT

STATESVILLE 704-878-5305 MOORESVILLE 704-664-5281

## IMPROVEMENT PERMIT / AUTHORIZATION TO CONSTRUCT / OPERATION PERMIT / EXISTING SYSTEM INSPECTION

PERMIT# 92965 PIN# 4679029878 4679028786 DATE 5/16/01

OWNER OR CONTRACTOR BEECHWOOD PARTNERS // Zachary Thomas PHONE: Business 664-9080 Home

ADDRESS 225 ROLLING HILLS RD - MOORESVILLE NC 28117

LOCATION 801 N - TL TRIPLETT RD - TL MALLARDWOOD - ON RT 112 Mallardwood Dr.

SUBDIVISION BEECHWOOD EST. BLOCK / SECTION LOT 3 LOT AREA .81AC SITE CLASS. PS DESIGN FLOW 360GPD L.T.A.R. .2560/FT²

Septic Tank: 1000 Gallons; STB 794 Date 4/9/02

Pump Tank: 1000 Gallons; PT 283 Date 3/12/02

Pump Make: BARNES Model 2EHV-331L Serial No. 110733

Nitrification Field: No Fields 1 Square Feet 1080 Linear Feet 360

No Lines 4@90' Trench Width 36" Max Trench Bottom Depth 36" Gravel Depth N/A

☑ New System ☐ Repair System Type: I, II, III, IV, V, VI

System Description: PUMP 25% REDUCTION

Repair System Description: SAME

Maintenance Agreement Required: ☐ Yes ☑ No

☑ House/Mod. Home No. Bedrooms 3

☐ Mobile Home No. Bathrooms 2

☐ Business No. Employees

☐ Other


☐ Slab ☑ Crawl Space ☐ Basement w/plumbing ☐ Basement wo/plumbing

Water Supply: ☑ Individual ☐ Public ☐ Community


Comments:/Conditions: 1) FRENCH DRAIN TO BE 48" DEEP UPSLOPE FROM SYSTEM AND OUT TO DAYLIGHT EXTENDING BELOW DRAINFIELD DOWN PROPERTY LINES. 2) KEEP LINES 10' DOWNSLOPE FROM DRAIN AND 15' FROM SIDE.

Comments:/Conditions:

INITIAL SITE SKETCH 1"=50'

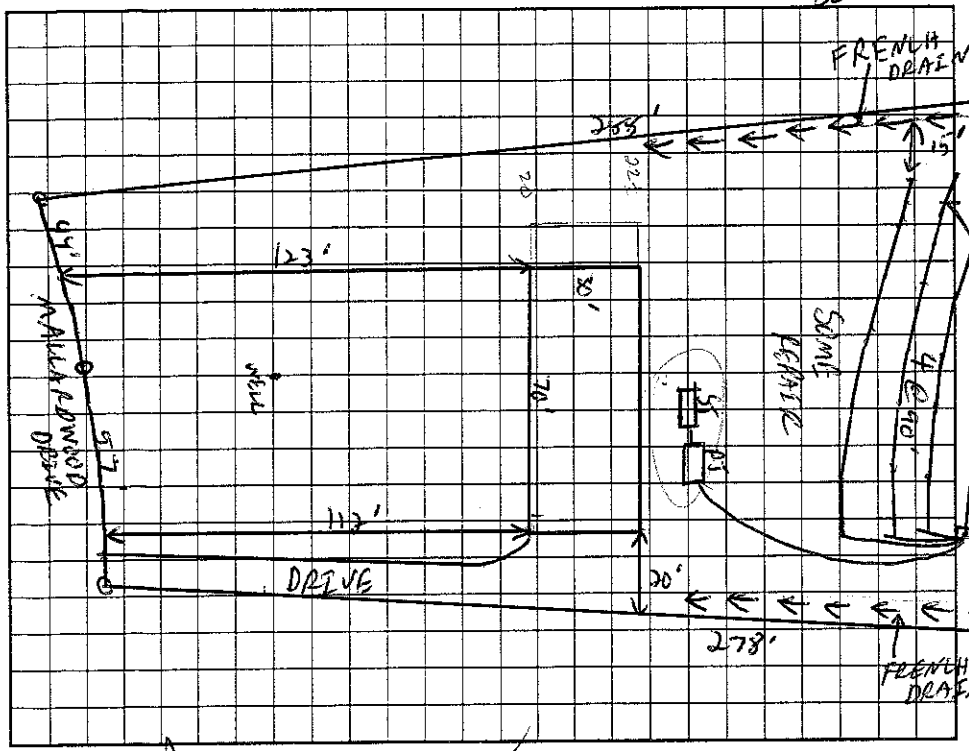


AS BUILT SKETCH

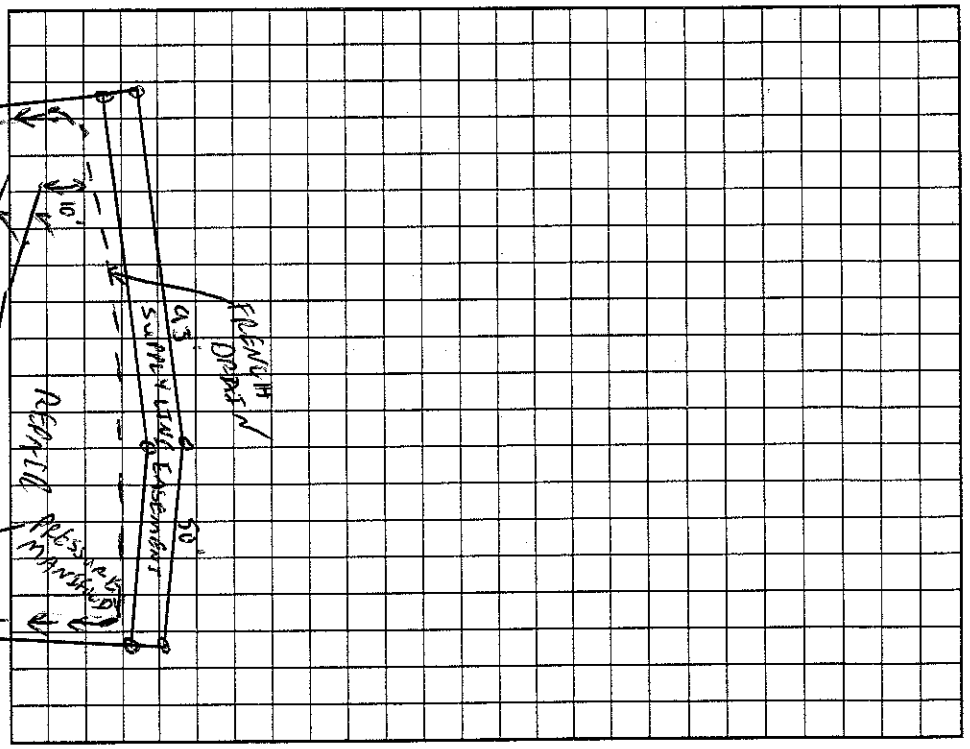


Permit can be suspended or revoked if any false information is supplied toward securing the permit/any unauthorized changes are made to the site/any unauthorized changes are made in the installation of the system. Improvement Permit with plat valid without expiration. Improvement Permit with site plan valid for sixty months. Authorization to Construct is valid for a period equal to that of Improvement Permit – not to exceed sixty months.

Signed: date

Improvement Permit by: C. G. Zeiger, RS date 5/16/01

Authorization to Construct by: Derek R. Henson, RS date 4/9/02

Installed by: Bobes Backhoe Service

Operation Permit by: RS date 6/20/02

Existing System Inspection by: date

HEALTH DEPT. COPY: WHITE OWNER COPY (FINAL): YELLOW OWNER COPY (INITIAL): PINK