IREDELL COUNTY HEALTH DEPARTMENT

Statesville Office (704) 878-5305 Mooresville Office (704) 660-3625 PERMIT # 1:30 ✓ 201029

IMPROVEMENT PERMIT / AUTHORIZATION TO CONSTRUCT / OPERATION PERMIT / EXISTING SYSTEM

PIN # 4679-03-3457

APPLICANT: Glenda P Hoyle APPLICANT ADDRESS: 6741 Hickory Ridge Rd Harrisburg NC

SITE ADDRESS: 2134 Triplette Rd PHONE: 704-455-2125 ALT. PHONE:

SITE DIRECTIONS: Hwy 115N, TR on Mazeppa Rd, Lot on L @ corner of Mazeppa and Triplett

SUBDIVISION: SECTION: LOT # 1 LOT AREA: 1.871 ac DESIGN FLOW: 360 gpd L.T.A.R.: 0.3


Septic Tank	EXISTING 6 (gal)	STB		Date		☐ New System ☑ Repair ☐ Expansion System Type: I II ◉ IV V VI	☑ Residence	No. Bedrooms	3
Pump Tank	1000 (gal)	PT	283	Date	5-26-14	System Description: CONVENTIONAL	☐ Business	No. Persons	6
Pump Make	Goulds	Model	WE0511H	Serial #		Repair System Description:	☐ Other	No. Employees	
# Nitrification Fields	1	# Lines	5	Linear Ft:	400	Maintenance Agreement Required: ☐ YES ☑ NO	☐ Slab	☑ Crawl Space	
Trench Width	36"	Max. Trench Bottom Depth	48"	Gravel Depth	12"	☐ GRAVITY ☑ PRESSURE	☐ Basement w/plumbing	☐ Basement w/o plumbing	

Water Supply: ☑ Private ☐ Public ☐ Community


Comments / Conditions: ✱ 48" TRENCH BOTTOM ✱
✱ Chambers may be used in place of gravel with no reduction in line length

✱ SCH 80 1/2 taps
✱ Pressure Set @ 2'
✱ Alarm Checked, Near 4X box SSE Manhole
✱ Lines Checked

INITIAL SITE SKETCH

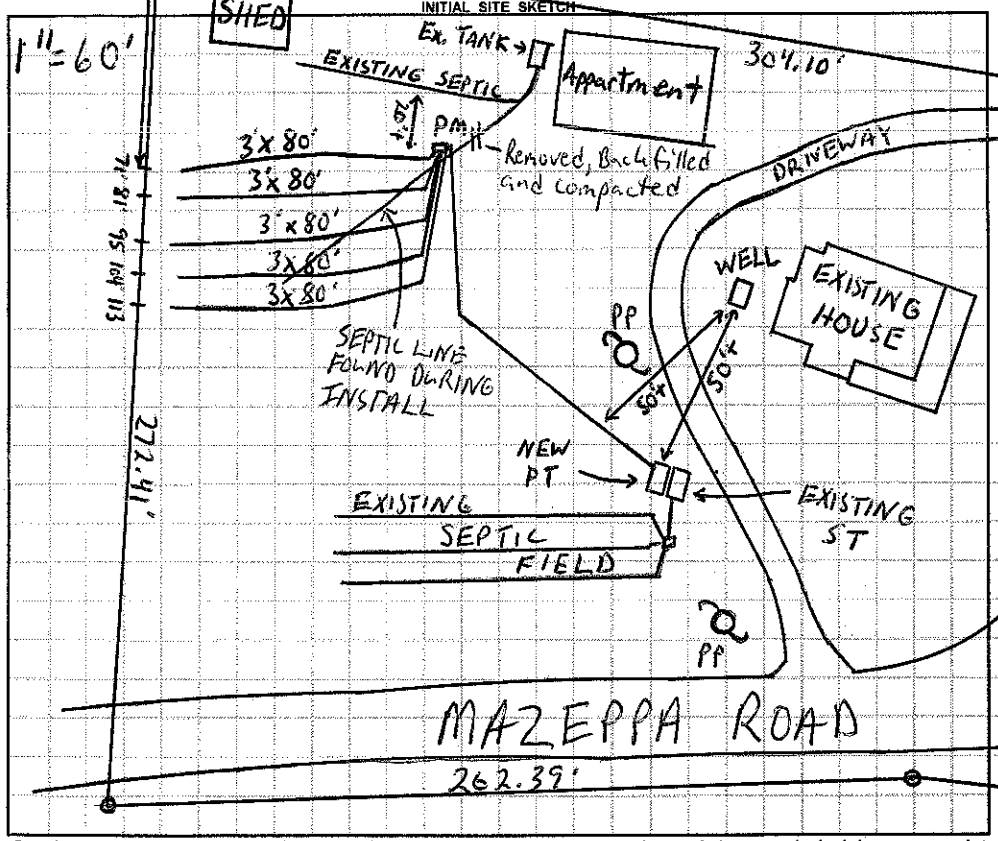

AS BUILT SKETCH

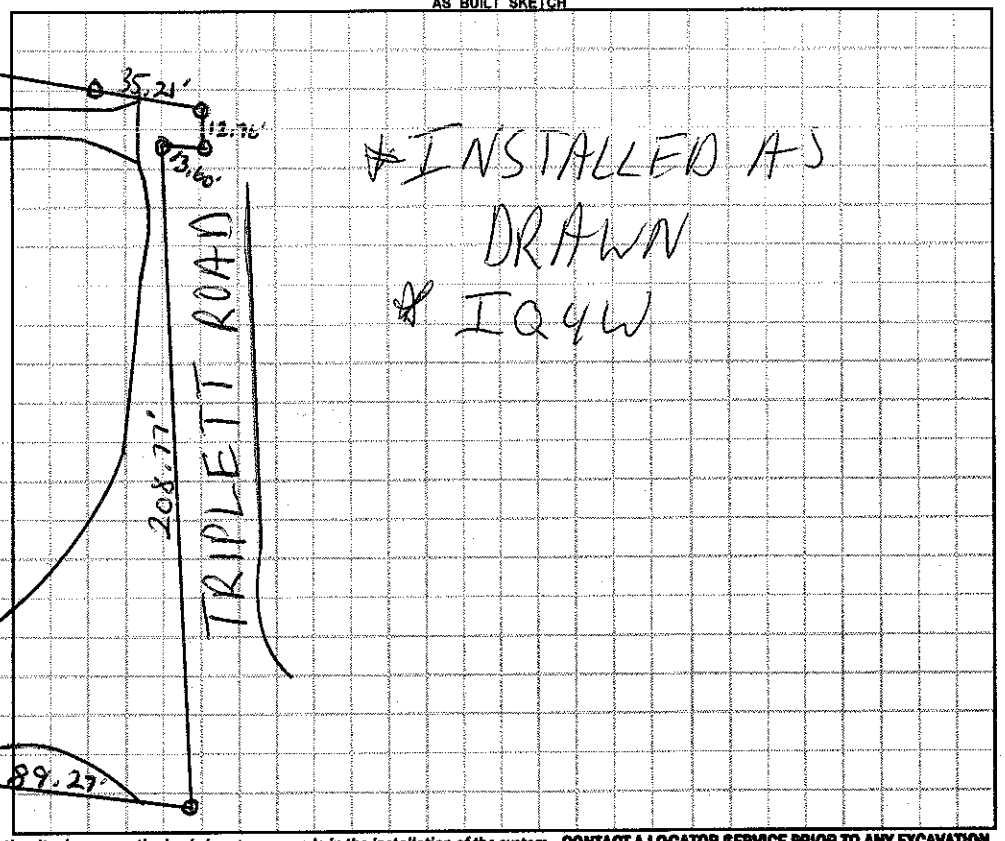

Permit can be suspended or revoked if any false information is supplied toward securing the permit / any unauthorized changes are made to the site / any unauthorized changes are made in the installation of the system. **CONTACT A LOCATOR SERVICE PRIOR TO ANY EXCAVATION**

☐ **IMPROVEMENT PERMIT** *with plat valid without expiration.* ☑ **IMPROVEMENT PERMIT** *with site plan valid for 60 mos.* ☑ **AUTHORIZATION TO CONSTRUCT** *valid for period equal to IMPROVEMENT PERMIT--not to exceed 60 mo.*

Owner / Applicant Signature: Edd Beam Date: 6-27-14 Installed by: L E Beam

IMPROVEMENT PERMIT by: Date: 6-26-14 OPERATION PERMIT by: Date: 7-9-14

AUTHORIZATION TO CONSTRUCT by: Date: 6-26-14 Existing System Inspected by: Date:

Health Dept. Copy - WHITE Applicant (Final Approval) - YELLOW Applicant (Conditional Approval) - PINK