IREDELL COUNTY HEALTH DEPARTMENT

STATESVILLE 704-878-5305 MOORESVILLE 704-664-5281

IMPROVEMENT PERMIT / AUTHORIZATION TO CONSTRUCT / OPERATION PERMIT / EXISTING SYSTEM INSPECTION

PERMIT# Repair PIN# 4679-03-9640 DATE 3-14-08

OWNER OR APPLICANT Gene Corriher PHONE: Business 704-941-4051 Home 704-663-4757

ADDRESS 867 Mazeppa Rd Cell

LOCATION Hwy 115, TR Mazeppa Rd, 2nd house past Triplett on left

SUBDIVISION — BLOCK / SECTION — LOT — LOT AREA SITE CLASS. DESIGN FLOW 360 L.T.A.R.

Septic Tank: Gallons; STB Date

Pump Tank: Gallons; PT Date

Pump Make: Model Serial No.

Nitrification Field: No Fields 1 Square Feet 450' Linear Feet 150'

No Lines 2@75' Trench Width 36" Max Trench Bottom Depth 36" Gravel Depth —

☐ New System ☐ Repair ☒ Expansion System Type: I II (III) IV V VI

System Description: Gravity 25% Red.

Repair System Description:

Maintenance Agreement Required: ☐ Yes ☒ No

☒ House/Mod. Home ☐ Mobile Home ☐ Business ☐ Other

No. Bedrooms 3 No. Persons 2 No. Employees


Water Supply: ☒ Individual ☐ Public ☐ Community

☒ Gravity ☐ Pressure ☐ Slab ☐ Crawl Space ☒ Basement w/plumbing ☐ Basement wo/plumbing


Comments:/Conditions:

Comments:/Conditions: Install 2 lines @ 75' - 25% Reduction 10' off of old bed system / Install new dist. box to feed lines & bed

INITIAL SITE SKETCH

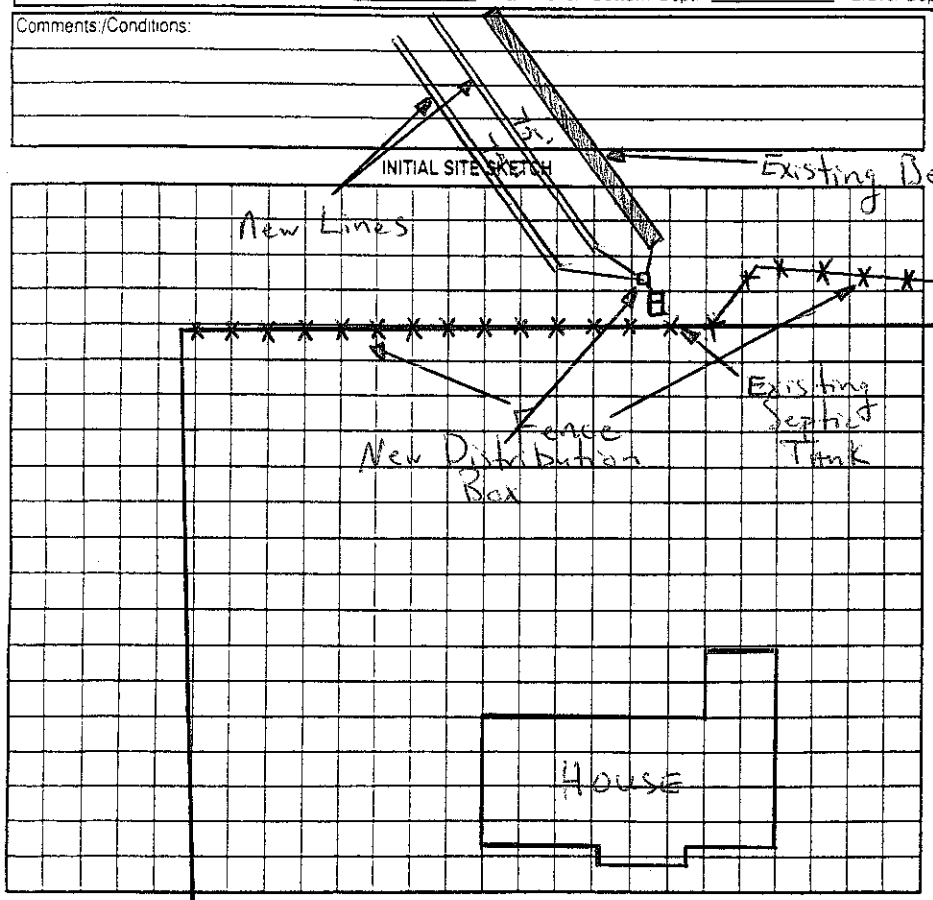

AS BUILT SKETCH

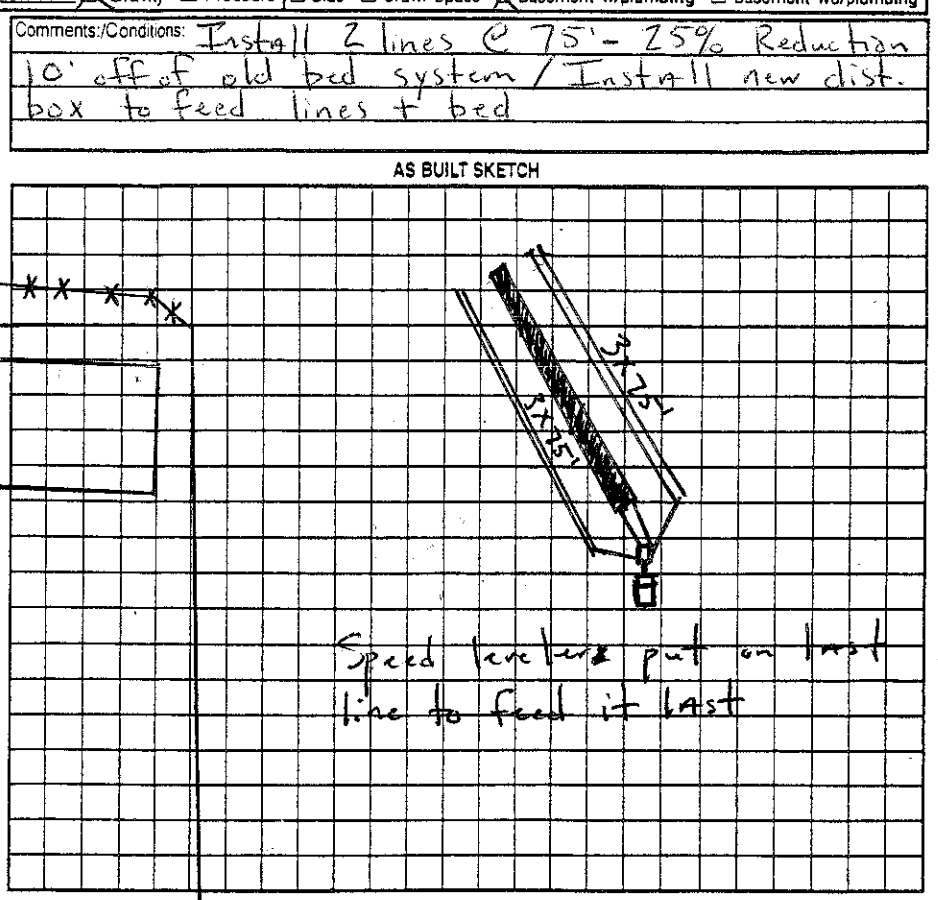

Permit can be suspended or revoked if any false information is supplied toward securing the permit/any unauthorized changes are made to the site/any unauthorized changes are made in the installation of the system. Improvement Permit with plat valid without expiration ☐ Improvement Permit with site plan valid for sixty months ☒ Authorization to Construct is valid for a period equal to that of Improvement Permit – not to exceed sixty months.

Signed: date

Improvement Permit by: RSI date 3-14-08

Authorization to Construct by: RSI date 3-14-08

Installed by: Wayne Orbison

Operation Permit by: date 3-25-08

Existing System Inspection by: date

HEALTH DEPT. COPY: WHITE OWNER COPY (FINAL): YELLOW OWNER COPY (INITIAL): PINK