IREDELL COUNTY HEALTH DEPARTMENT

SVILLE 704-878-5305 MOORESVILLE 704-664-5281

IMPROVEMENT PERMIT / AUTHORIZATION TO CONSTRUCT / OPERATION PERMIT / EXISTING SYSTEM INSPECTION

PERMIT# Repair PIN# 4679 05 4417 DATE 4/25/05

OWNER OR CONTRACTOR Gary B. Wagner PHONE: Business 7046643050 Home 704 663 3090

ADDRESS 2039 Triplett Rd Mt. Ulla 28125

LOCATION 801 N, TL Triplett, 1/2 mile past Mazeppa Rd on Rt - 2039 Triplett Rd

SUBDIVISION _____ BLOCK / SECTION _____ LOT _____ LOT AREA _____ SITE CLASS. PS DESIGN FLOW 360 L.T.A.R. _____

Septic Tank: Existing Gallons: STB _____ Date _____

Pump Tank: _____ Gallons: PT _____ Date _____

Pump Make: _____ Model _____ Serial No. _____

Nitrification Field: No Fields 1 Square Feet 1000 Linear Feet 100'

No Lines _____ Trench Width 10' Max Trench Bottom Depth 36" Gravel Depth 12"

☐ New System ☒ Repair System Type: I II III IV, V, VI

System Description: _____

Repair System Description: 10'x100' Conventional Bed

Maintenance Agreement Required: ☐ Yes ☒ No

☒ House/Mod. Home No. Bedrooms 3

☐ Mobile Home No. Bathrooms _____

☐ Business No. Employees _____

☐ Other _____


☐ Slab ☒ Crawl Space ☐ Basement w/plumbing ☐ Basement wo/plumbing

Water Supply: ☒ Individual ☐ Public ☐ Community

Comments:/Conditions:

Comments:/Conditions:

INITIAL SITE SKETCH

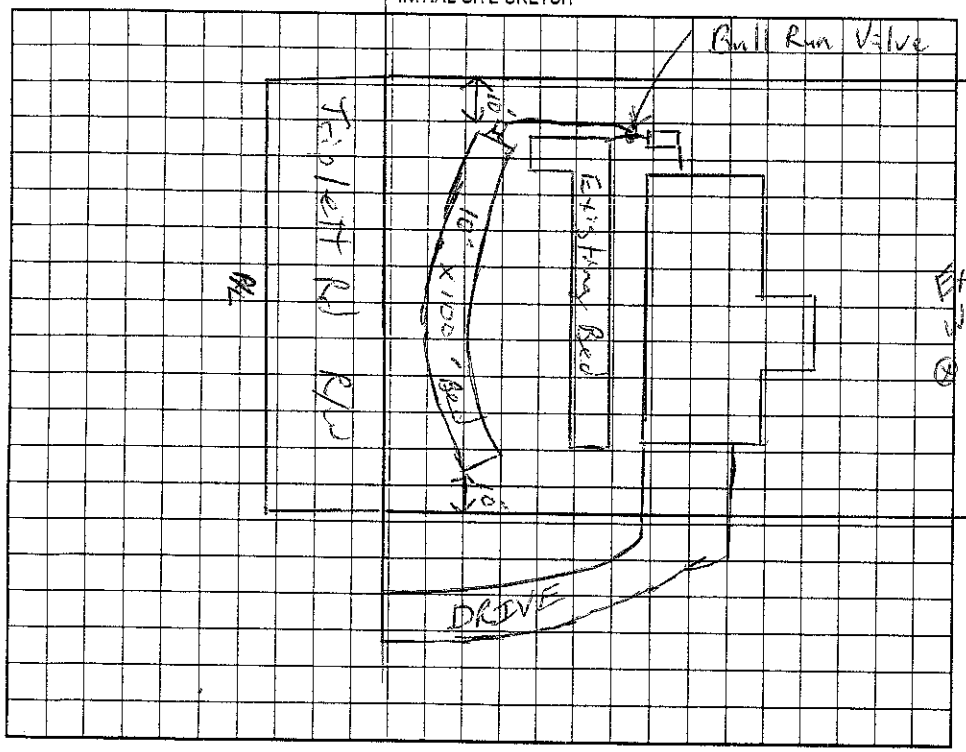

AS BUILT SKETCH

EZ Flow Installed

Permit can be suspended or revoked if any false information is supplied toward securing the permit/any unauthorized changes are made to the site/any unauthorized changes are made in the installation of the system. Improvement Permit without valid without expiration. Improvement Permit with site plan valid for sixty months. Authorization to Construct is valid for a period equal to that of Improvement Permit – not to exceed sixty months.

Signed: Gary B. Wagner date 4/26/05 Installed by: Larry Beaver

Improvement Permit by: RS date 4/25/05 Operation Permit by: RS date 6/23/05

Authorization to Construct by: RS date 4/25/05 Existing System Inspection by: _____ date _____

HEALTH DEPT. COPY: WHITE OWNER COPY (FINAL): YELLOW OWNER COPY (INITIAL): PINK