IREDELL COUNTY HEALTH DEPARTMENT

STATESVILLE 704-878-5305 MOORESVILLE 704-664-5281

IMPROVEMENT PERMIT / AUTHORIZATION TO CONSTRUCT / OPERATION PERMIT / EXISTING SYSTEM INSPECTION

PERMIT# 146413 PIN# 4679074132 DATE 11-29-07

OWNER OR APPLICANT Barbara Jean Homes Inc. PHONE: Business 704-641-7009 Home

ADDRESS 112 Wisteria Ln

LOCATION 115 N TR Mazeppa TL Triplett on left white fence 1964 Triplett Rd

SUBDIVISION BLOCK / SECTION LOT LOT AREA 12 Ac. SITE CLASS PS DESIGN FLOW 360gpd L.T.A.R. .3 gpd/ft2

Septic Tank: 1000 Gallons: STB 512 Date 11/11/08

Pump Tank: Gallons: PT Date

Pump Make: Model Serial No.

Nitrification Field: No Fields 1 Square Feet 900 Linear Feet 300

No Lines 3 Trench Width 36" Max Trench Bottom Depth 30" Gravel Depth NA

☒ New System ☐ Repair ☐ Expansion System Type: I II III IV V VI

System Description: 25% reduction gravity

Repair System Description: 25% reduction gravity

Maintenance Agreement Required: ☐ Yes ☒ No

☒ Gravity ☐ Pressure

☒ House/Mod. Home No. Bedrooms 3

☐ Mobile Home No. Persons 6

☐ Business No. Employees

☐ Other


Water Supply: ☒ Individual ☐ Public ☐ Community

☐ Slab ☒ Crawl Space ☐ Basement w/plumbing ☐ Basement wo/plumbing

Comments:/Conditions:
1" = 100'
See attached for full property dimensions
Shave Berms below system lines to shed water

Comments:/Conditions:
Replacing existing house with new house
Applicant chooses to abandon existing system & replace with new system
Existing system not located

INITIAL SITE SKETCH

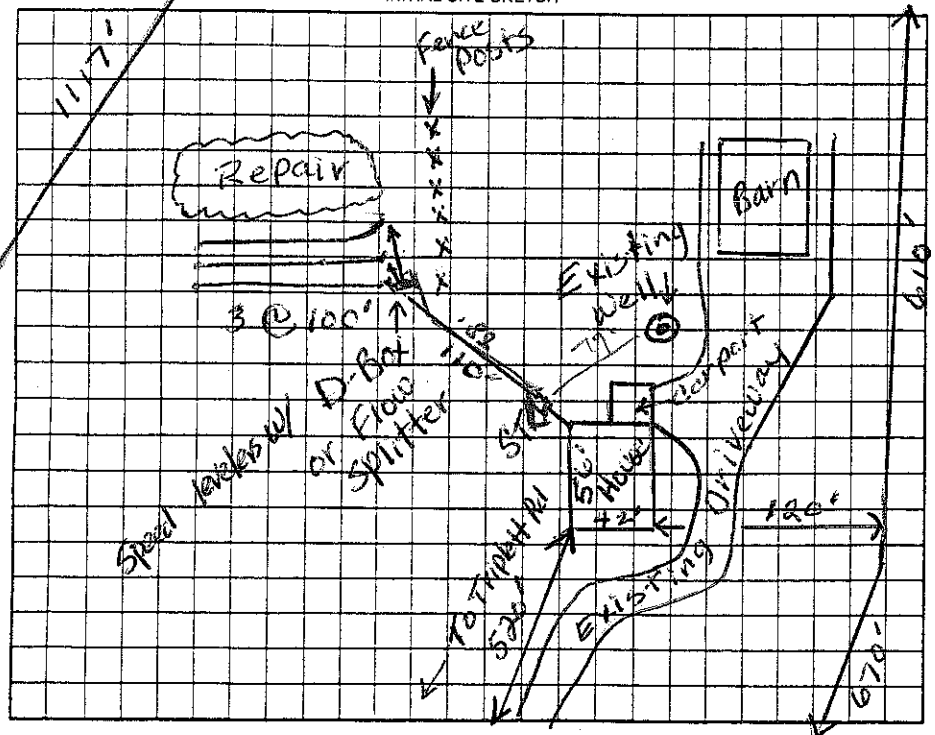

AS BUILT SKETCH

Permit can be suspended or revoked if any false information is supplied toward securing the permit/any unauthorized changes are made to the site/any unauthorized changes are made in the installation of the system. Improvement Permit with plat valid without expiration ☐ Improvement Permit with site plan valid for sixty months ☒ Authorization to Construct is valid for a period equal to that of Improvement Permit – not to exceed sixty months.

Signed: Robert C. Rill date 11-30-07 Installed by: Larry Beam

Improvement Permit by: Judy Melville date 11-29-07 Operation Permit by: Wesley Sparks RS date 3/25/08

Authorization to Construct by: Judy Melville date 11-29-07 Existing System Inspection by: date

HEALTH DEPT. COPY: WHITE OWNER COPY (FINAL): YELLOW OWNER COPY (INITIAL): PINK