IREDELL COUNTY HEALTH DEPARTMENT

STATESVILLE 704-878-5305 MOORESVILLE 704-664-5281

IMPROVEMENT PERMIT / AUTHORIZATION TO CONSTRUCT / OPERATION PERMIT / EXISTING SYSTEM INSPECTION

PERMIT# 107829 PIN# 4679-08-0632 DATE 7/24/02

OWNER OR CONTRACTOR Discover Building LLC PHONE: Business 704-663-6533 Home

ADDRESS 2220 Broadshow Rd Mooresville NC 28115

LOCATION 801, TL Tripplett on Lt past Confederate Rd.

SUBDIVISION BLOCK / SECTION LOT LOT AREA 22.28 SITE CLASS. PS DESIGN FLOW 240 L.T.A.R. 0.35

Septic Tank: 1000 Gallons; STB 825 Date 8/14/02
Pump Tank: Gallons; PT Date
Pump Make: Model Serial No.
Nitrification Field: No Fields 1 Square Feet 684 Linear Feet 228
No Lines 3@76' Trench Width 36" Max Trench Bottom Depth 36" Gravel Depth 12"

[X] New System [ ] Repair System Type: I, (II), III, IV, V, VI
System Description: Gravity Conventional
Repair System Description: Same
Maintenance Agreement Required: [ ] Yes [X] No

[X] House/Mod. Home No. Bedrooms 2
[ ] Mobile Home No. Bathrooms 1½
[ ] Business No. Employees
[ ] Other

[X] Slab [ ] Crawl Space [ ] Basement w/plumbing [ ] Basement wo/plumbing


Water Supply: [X] Individual [ ] Public [ ] Community

Comments:/Conditions: Keep well 100' from septic System minimum

Comments:/Conditions:

P/L

INITIAL SITE SKETCH

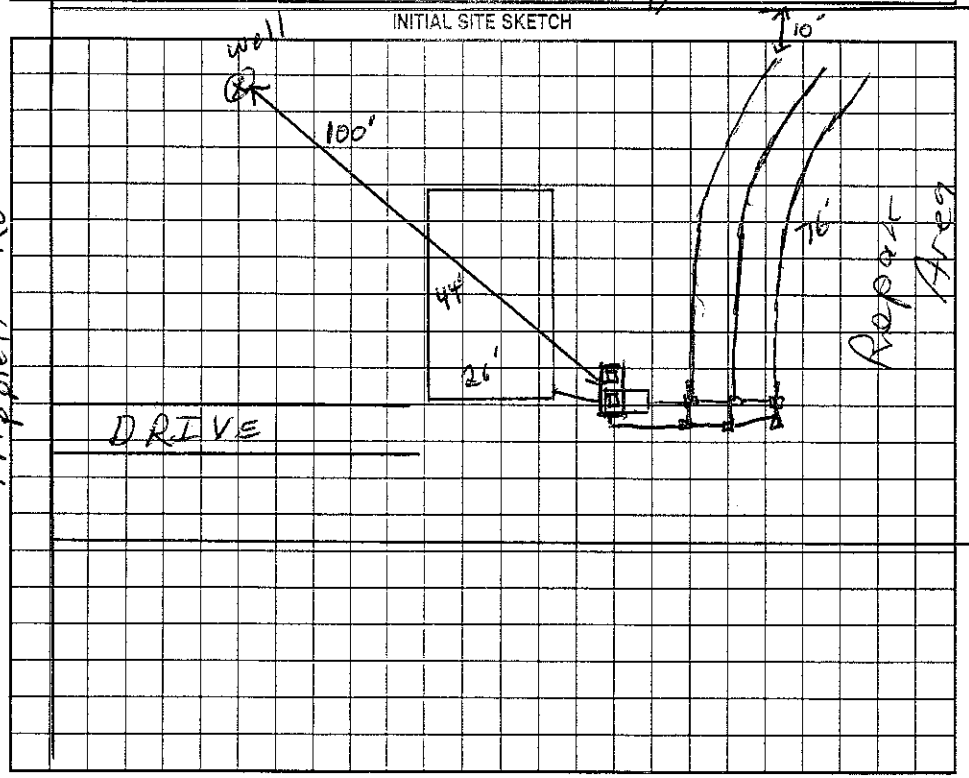

Not to Scale

AS BUILT SKETCH

Permit can be suspended or revoked if any false information is supplied toward securing the permit/any unauthorized changes are made to the site/any unauthorized changes are made in the installation of the system. Improvement Permit with plat valid without expiration. Improvement Permit with site plan valid for sixty months. Authorization to Construct is valid for a period equal to that of Improvement Permit – not to exceed sixty months.

Signed: date 7-25-02 Installed by: Rowan Septic Tank

Improvement Permit by: RS date 7/24/02 Operation Permit by: Wesley Hanks RS. date 10/7/02

Authorization to Construct by: RS date 7/24/02 Existing System Inspection by: date

HEALTH DEPT. COPY: WHITE OWNER COPY (FINAL): YELLOW OWNER COPY (INITIAL): PINK