IREDELL COUNTY HEALTH DEPARTMENT

STATESVILLE 704-878-5305 MOORESVILLE 704-664-5281

IMPROVEMENT PERMIT / AUTHORIZATION TO CONSTRUCT / OPERATION PERMIT / EXISTING SYSTEM INSPECTION

PERMIT# 93007 PIN# ~~4679025478~~ PT 4679-11-0707 DATE 1/8/01

OWNER OR CONTRACTOR BEECHWOOD PARTNERS / OAKWOOD HOMES PHONE: Business 664-9080 Home

ADDRESS 225 ROLLING HILLS RD - MOORESVILLE

LOCATION 801 N- TL TRIPLETT - TL MALLARDWOOD - TL WOODBENE - ON RT

SUBDIVISION BEECHWOOD EST BLOCK / SECTION LOT 18 LOT AREA .84AC SITE CLASS PS DESIGN FLOW ~~480~~ 600 GPD L.T.A.R. - 3000 SQ FT

Septic Tank: 1000 Gallons; STB 794 Date 3/9/01

Pump Tank: Gallons; PT Date

Pump Make: Model Serial No.

Nitrification Field: No Fields 1 Square Feet 1200 Linear Feet ~~1200~~ 400

No Lines 4 @ 100' Trench Width 36" Max Trench Bottom Depth 36" Gravel Depth N/A

☑ New System ☐ Repair System Type: I, II, (III) IV, V, VI

System Description: GRAVITY 25% REDUCTION

Repair System Description: SAME / PANEL

Maintenance Agreement Required: ☐ Yes ☑ No

☑ House/Mod. Home No. Bedrooms ~~3~~ 4

☑ Mobile Home No. Bathrooms 3

☐ Business No. Employees

☐ Other


☐ Slab ☑ Crawl Space ☐ Basement w/plumbing ☐ Basement wo/plumbing

Water Supply: ☑ Individual ☐ Public ☐ Community


Comments:/Conditions:

Comments:/Conditions:

INITIAL SITE SKETCH 1"=50'

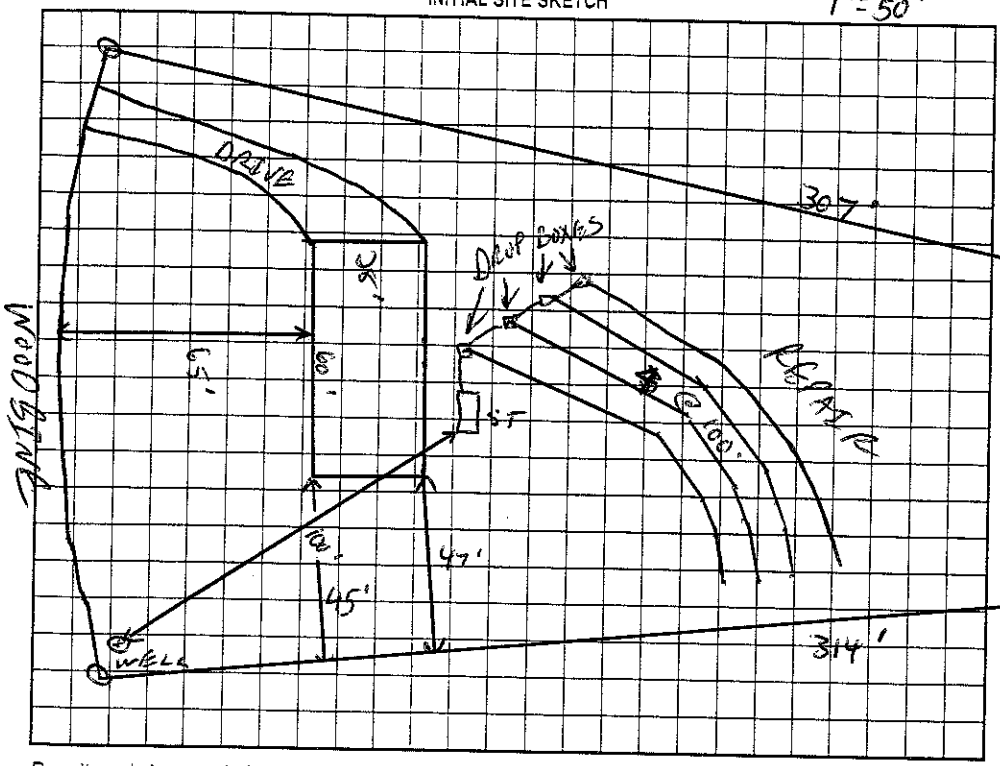

AS BUILT SKETCH

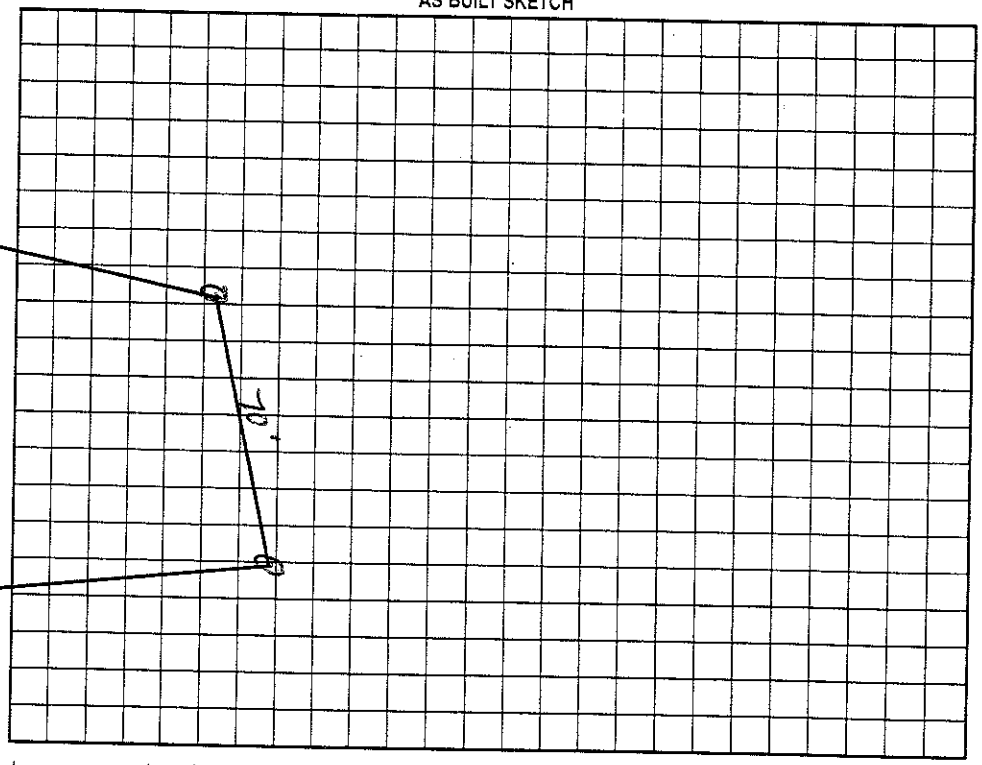

Permit can be suspended or revoked if any false information is supplied toward securing the permit/any unauthorized changes are made to the site/any unauthorized changes are made in the installation of the system. Improvement Permit with plat valid without expiration. Improvement Permit with site plan valid for sixty months. Authorization to Construct is valid for a period equal to that of Improvement Permit – not to exceed sixty months.

Signed: [signature] date 1/29/01

Improvement Permit by: C. Gaines RS date 1/8/01

Authorization to Construct by: C. Gaines RS date 3/26/01

Installed by: Marty Tucker

Operation Permit by: [signature] M Ivey RSI date 4/12/01

Existing System Inspection by: date

HEALTH DEPT. COPY: WHITE OWNER COPY (FINAL): YELLOW OWNER COPY (INITIAL): PINK