IREDELL COUNTY HEALTH DEPARTMENT

STATESVILLE 704-878-5305 MOORESVILLE 704-664-5281

IMPROVEMENT PERMIT / AUTHORIZATION TO CONSTRUCT / OPERATION PERMIT / EXISTING SYSTEM INSPECTIO

PERMIT# 142452 PIN# 4679 11 1119 DATE 5/30/07

OWNER OR APPLICANT Beechwood Partners LLC PHONE: Business 704-664-9080 Home

ADDRESS 255 Rolling Hills Rd. Mooresville, NC. 28117

LOCATION 140 Woodbine Ct, ROI N TL Mayppa Rd. TL Mallardwood TL Woodbine, off end of Cul de sac

SUBDIVISION Beechwood Estates BLOCK / SECTION 381 LOT 23 LOT AREA 1.09Ac SITE CLASS. PS DESIGN FLOW 480 L.T.A.R. .3

Septic Tank: 1000 Gallons: STB 760 Date 11/3/08

Pump Tank: Gallons: Date

Pump Make: Model Serial No.: 300'

Nitrification Field: No Field Square Feet 1200 Linear Feet 400

No Lines 5 x 80' Trench Width 3' Max Trench Bottom Depth 24" Gravel Depth No

☒ New System ☐ Repair ☐ Expansion System Type: I II III IV V VI

System Description: Plenty - 25% Reduction

Repair System Description: 16" PPBPS

Maintenance Agreement Required: ☐ Yes ☒ No

☒ House/Mod. Home ☐ Mobile Home ☐ Business ☐ Other

No. Bedrooms 4 No. Persons No. Employees

Water Supply: ☒ Individual ☐ Public ☐ Community


☒ Gravity ☐ Pressure ☐ Slab ☒ Crawl Space ☐ Basement w/plumbing ☐ Basement wo/plumbing

4075'

Comments:/Conditions: REPAIR AREA

Comments:/Conditions: 4/15/09 Plans essentially same as I.P. AC

INITIAL SITE SKETCH

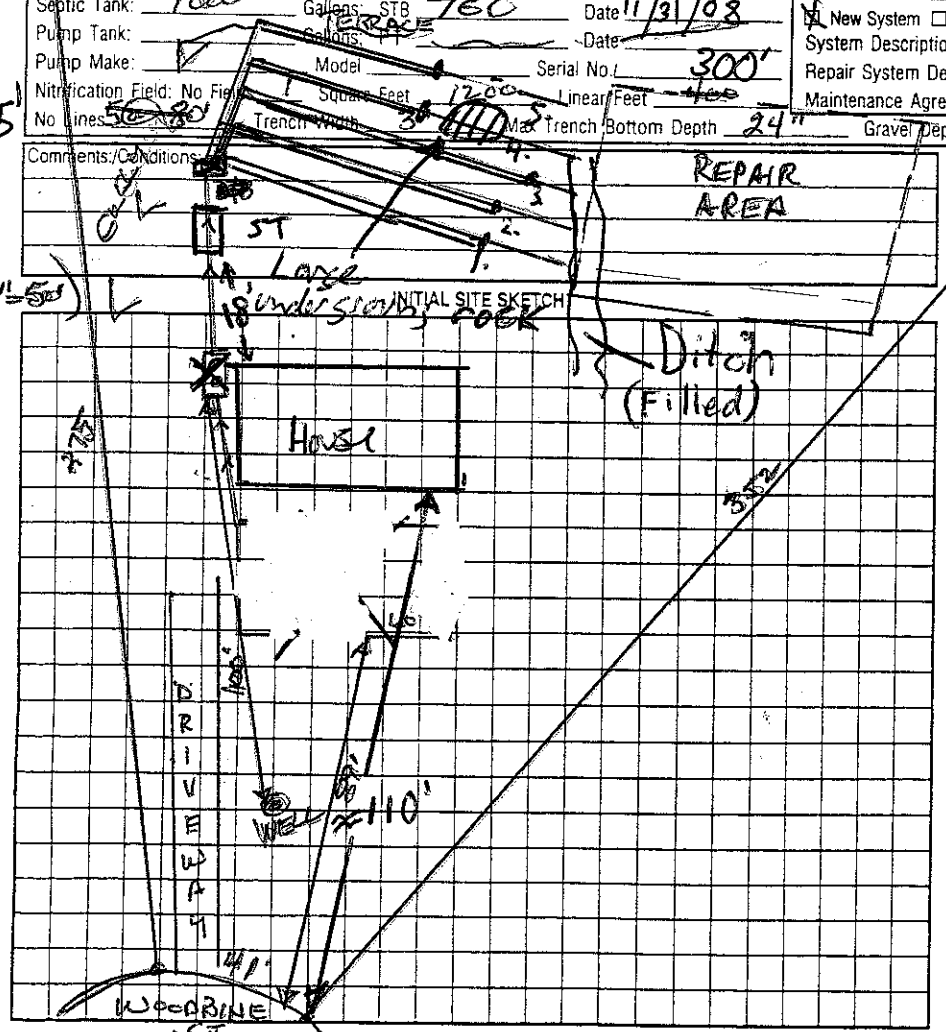

AS BUILT SKETCH

4/23/09 System installed with Changes shown. Drainlines Length 1) 72' 2) 72' 3) 76' 4) 44' 5) 44'

start of Line 5 is app. 50' from back property line

- As built changes not to scale.

Inf. Harbor Quick 4 installed w/ end cap serial distribution.

Large underground rocks found during installation cause for line length changes.

Permit can be suspended or revoked if any false information is supplied toward securing the permit/any unauthorized changes are made to the site/any unauthorized changes are made in the installation of the system. Improvement Permit with plat valid without expiration ☒ Improvement Permit with site plan valid for sixty months ☐ Authorization to Construct is valid for a period equal to that of Improvement Permit – not to exceed sixty months.

Signed: X date 6-28-07

Improvement Permit by: Wade Spencer R.S. date 5/30/07

Authorization to Construct by: Anthony Cohen Jr. date 4/15/09

Installed by: A-1 Backhoe

Operation Permit by: Anthony Cohen Jr. R.S. date 4/24/09

Existing System Inspection by: date

HEALTH DEPT. COPY: WHITE OWNER COPY (FINAL): YELLOW OWNER COPY (INITIAL): PINK