IMPROVEMENT PERMIT / AUTHORIZATION TO CONSTRUCT / OPERATION PERMIT / EXISTING SYSTEM INSPECTION

STATESVILLE 704-878-5305 /55.00 MOORESVILLE 704-664-5281

PERMIT# 093013 PIN# 4679 02 9878 PT

OWNER OR CONTRACTOR BEECHWOOD PARTNERS

ADDRESS 225 ROLLING HILLS RD MOORESVILLE PHONE: Business 664-9480 Home DATE 4/05/02

LOCATION SOL N - TL TREPLETT - [redacted] - TL MALLARDWOOD - TL WOODBINE - AT END

SUBDIVISION BEECHWOOD EST BLOCK / SECTION LOT 23 LOT AREA 1.09AC SITE CLASS PS DESIGN FLOW 360GPD L.T.A.R. .3600/FS

Septic Tank: 1000 Gallons; STB Date

Pump Tank: Gallons; PT Date

Pump Make: Model Serial No.

Nitrification Field: No Fields 1 Square Feet 1100 Linear Feet 300

No Lines 5 @ 60' Trench Width 36" Max Trench Bottom Depth 24" Gravel Depth N/A

☑ New System ☐ Repair System Type: I, II, (III), IV, V, VI

System Description: GRAVITY INNOVATIVE

Repair System Description: LPP

Maintenance Agreement Required: ☐ Yes ☑ No

☑ House/Mod. Home ☐ Mobile Home ☐ Business ☐ Other

No. Bedrooms 3 No. Bathrooms 3 No. Employees

☐ Slab ☑ Crawl Space ☐ Basement w/plumbing ☐ Basement wo/plumbing

Water Supply: ☑ Individual ☐ Public ☐ Community


Comments:/Conditions:

1) SEPTIC SYSTEM TO BE 100' FROM WELL


Comments:/Conditions:

INITIAL SITE SKETCH

NO SCALE

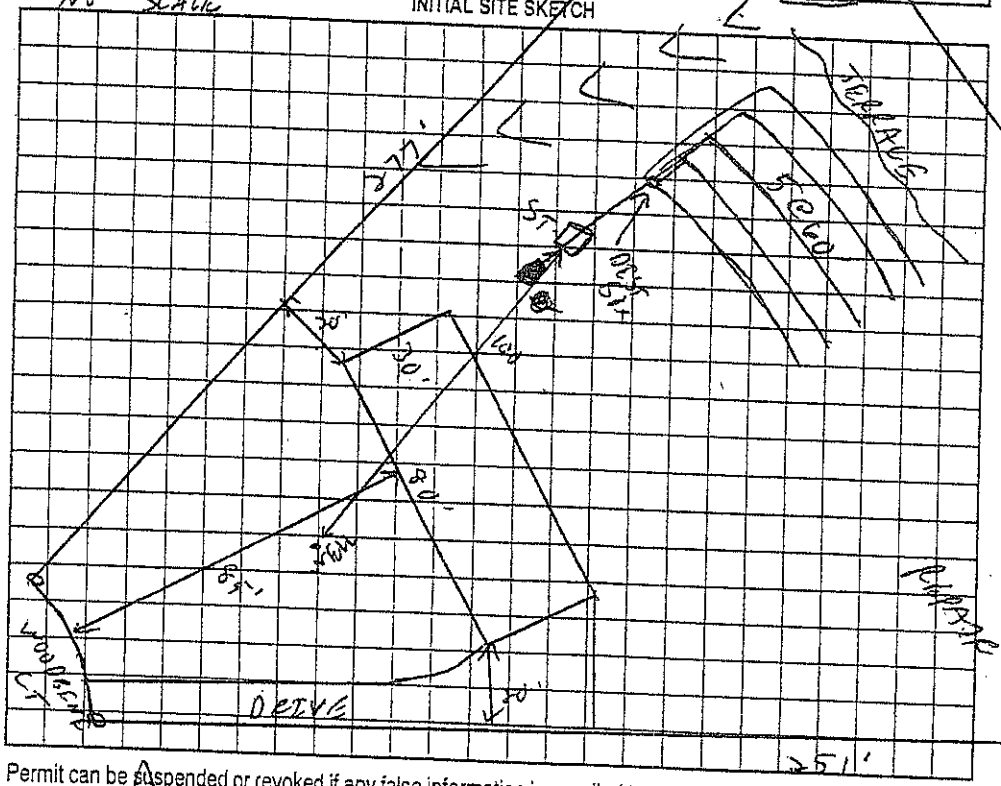

AS BUILT SKETCH

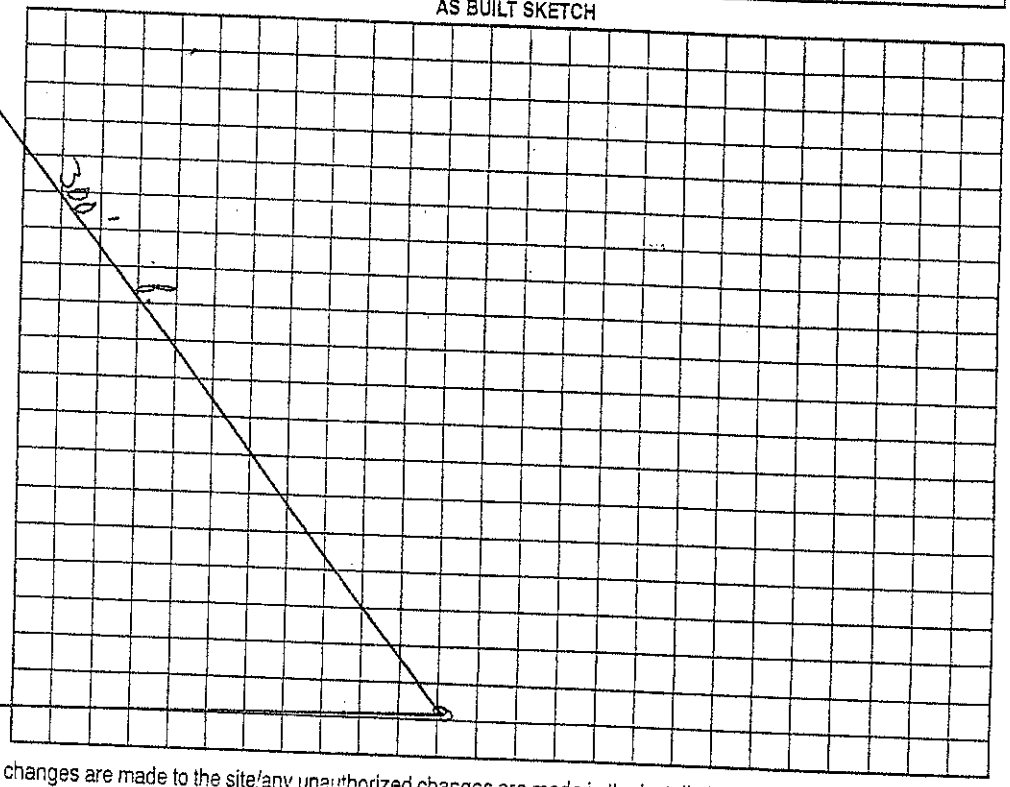

Permit can be suspended or revoked if any false information is supplied toward securing the permit/any unauthorized changes are made to the site/any unauthorized changes are made in the installation of the system. Improvement Permit with plat valid without expiration. Improvement Permit with site plan valid for sixty months. Authorization to Construct is valid for a period equal to that of Improvement Permit – not to exceed sixty months.

Signed: date 4/24/02 Installed by:

Improvement Permit by: C. Sykes ES date 4/08/02 Operation Permit by: date

Authorization to Construct by: C. Sykes ES date 4/08/02 Existing System Inspection by: date

HEALTH DEPT. COPY: WHITE OWNER COPY (FINAL): YELLOW OWNER COPY (INITIAL): PINK