IREDELL COUNTY HEALTH DEPARTMENT

STATESVILLE 704-878-5305 MOORESVILLE 704-664-5281

IMPROVEMENT PERMIT / AUTHORIZATION TO CONSTRUCT / OPERATION PERMIT / EXISTING SYSTEM INSPECTION

PERMIT# 93014 PIN# ~~4677-05-9878-PI~~ 4679-11-3220 DATE 12/8/00

OWNER OR CONTRACTOR BEECHWOOD PARTNERS / FLEETWOOD HOMES PHONE: Business 664-9080 Home

ADDRESS 225 ROLLING HILLS RD - MOORESVILLE NC 28117

LOCATION 801 N- TL TRIPLETT RD - TL MALLARDWOOD - TL WOODBINE - AT END

SUBDIVISION BEECHWOOD EST BLOCK / SECTION LOT 24 LOT AREA 1.43AC SITE CLASS. RS DESIGN FLOW 360GPD L.T.A.R. .3000/AC

Septic Tank: 1000 Gallons; STB 794 Date 2-27-00
Pump Tank: Gallons; PT Date
Pump Make: Model Serial No.
Nitrification Field: No Fields 1 Square Feet 1200 Linear Feet 400
No Lines 4@100' Trench Width 36" Max Trench Bottom Depth 36" Gravel Depth 12"

☑ New System ☐ Repair System Type: I (II) III, IV, V, VI
System Description: GRAVITY CONVENTIONAL
Repair System Description: SAME
Maintenance Agreement Required: ☐ Yes ☑ No


☑ House/Mod. Home No. Bedrooms 3
☐ Mobile Home No. Bathrooms 2
☐ Business No. Employees
☐ Other
☐ Slab ☑ Crawl Space ☐ Basement w/plumbing ☐ Basement wo/plumbing

Water Supply: ☑ Individual ☐ Public ☐ Community


Comments:/Conditions: 1) KEEP WELL 100' FROM SEPTIC SYSTEM AND REPAIR

Comments:/Conditions:

1"=60' INITIAL SITE SKETCH

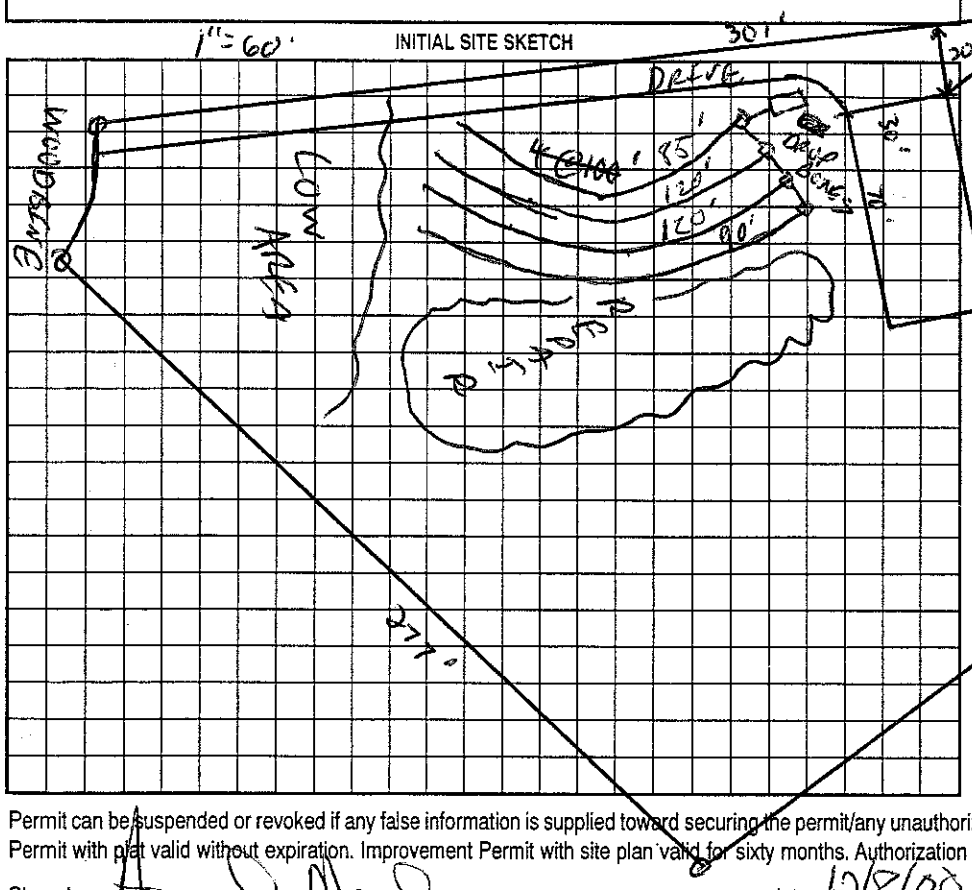

AS BUILT SKETCH

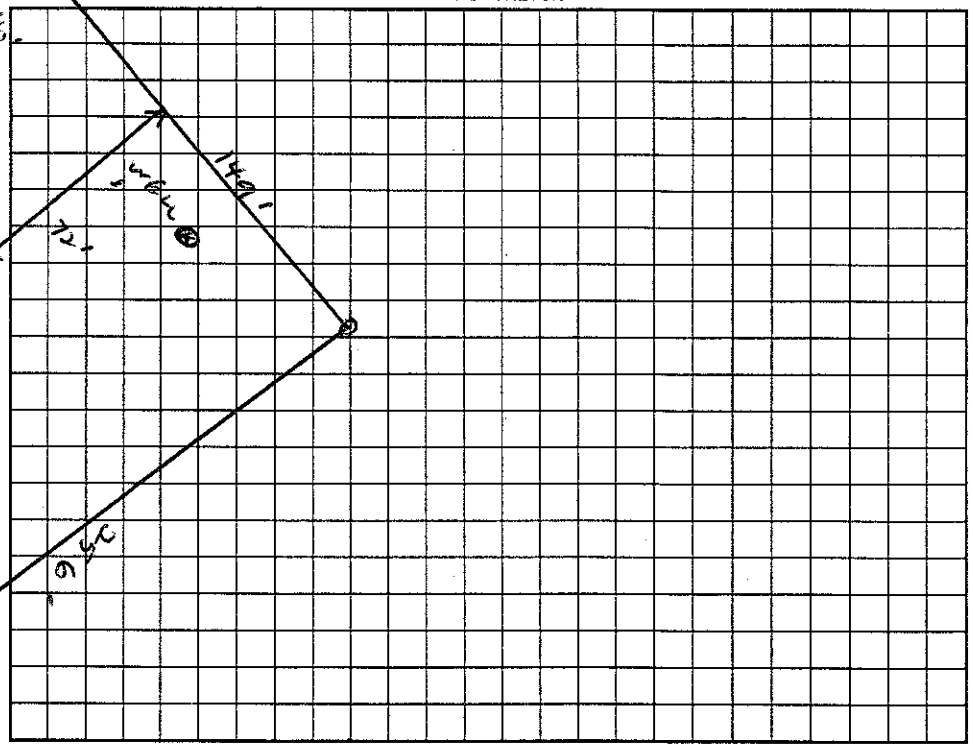

Permit can be suspended or revoked if any false information is supplied toward securing the permit/any unauthorized changes are made to the site/any unauthorized changes are made in the installation of the system. Improvement Permit with plat valid without expiration. Improvement Permit with site plan valid for sixty months. Authorization to Construct is valid for a period equal to that of Improvement Permit – not to exceed sixty months.

Signed: [signature] date 12/8/00 Installed by: Craig Thompson

Improvement Permit by: [signature] date 12/8/00 Operation Permit by: [signature] RSI date 1/25/01

Authorization to Construct by: [signature] date 1/8/01 Existing System Inspection by: date

HEALTH DEPT. COPY: WHITE OWNER COPY (FINAL): YELLOW OWNER COPY (INITIAL): PINK