12268

7:30

# IREDELL COUNTY HEALTH DEPARTMENT

STATESVILLE 704-878-5305 MOORESVILLE 704-664-5281

## IMPROVEMENT PERMIT / AUTHORIZATION TO CONSTRUCT / OPERATION PERMIT / EXISTING SYSTEM INSPECTION

PERMIT# 930167 PIN# ~~4679 02 9875~~ RT Expression Homes 4679-11-3447 DATE 1/10/01

OWNER OR CONTRACTOR BEECHWOOD PARTNERS / ~~Beechwood Homes~~ PHONE: Business 664-9050 Home

ADDRESS 225 ROLLING HILLS RD MOORESVILLE

LOCATION 801 N. TL TRIPLETT. TL MALLARDWOOD - TL WOODBINE - ON LT

SUBDIVISION BEECHWOOD EST. BLOCK / SECTION LOT 26 LOT AREA .7Ac SITE CLASS. PS DESIGN FLOW 360GPD L.T.A.R. .2-.25gal/ft2

Septic Tank: 1000 Gallons; STB 1012 Date 10-30-01

Pump Tank: Gallons; PT Date

Pump Make: Model Serial No.

Nitrification Field: No Fields 1 Square Feet 1200 Linear Feet 400

No Lines 4@100' Trench Width 36" Max Trench Bottom Depth 24" Gravel Depth N/A

☑ New System ☐ Repair System Type: I, II, III, IV, V, VI

System Description: GRAVITY 25% REDUCTION

Repair System Description: PUMP SAVE

Maintenance Agreement Required: ☐ Yes ☑ No

☑ House/Mod. Home No. Bedrooms 3

☐ Mobile Home No. Bathrooms 3

☐ Business No. Employees

☐ Other

☐ Slab ☑ Crawl Space ☐ Basement w/plumbing ☐ Basement wo/plumbing

Water Supply: ☐ Individual ☐ Public ☐ Community


Comments:/Conditions:

Comments:/Conditions:


Yellow filter

Well not installed at time of inspection

INITIAL SITE SKETCH 1"=50'

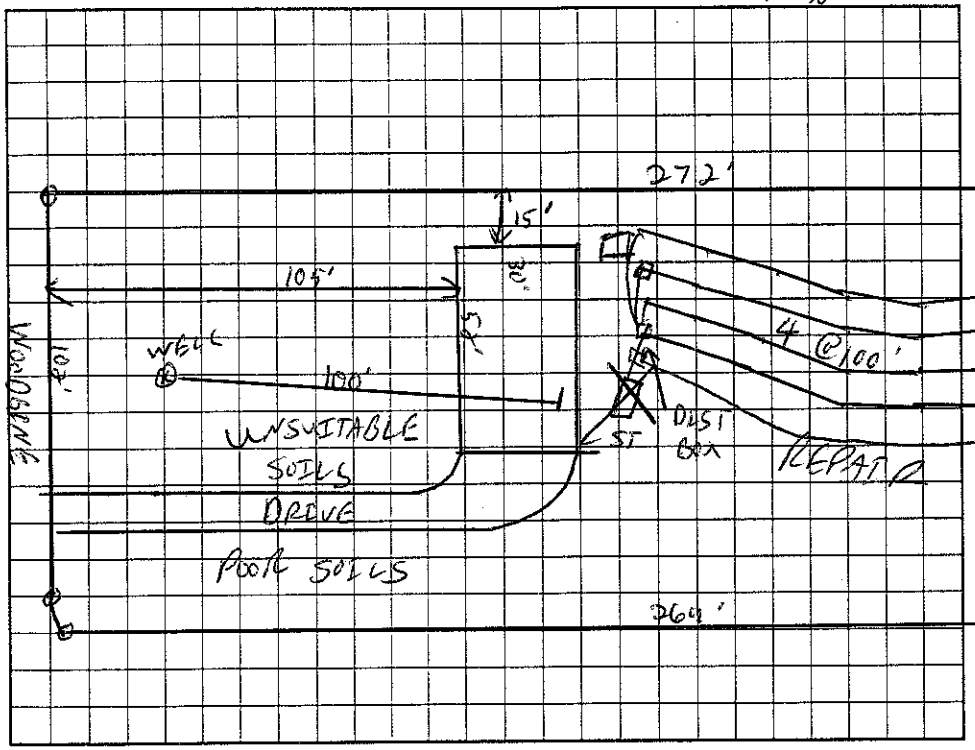


AS BUILT SKETCH

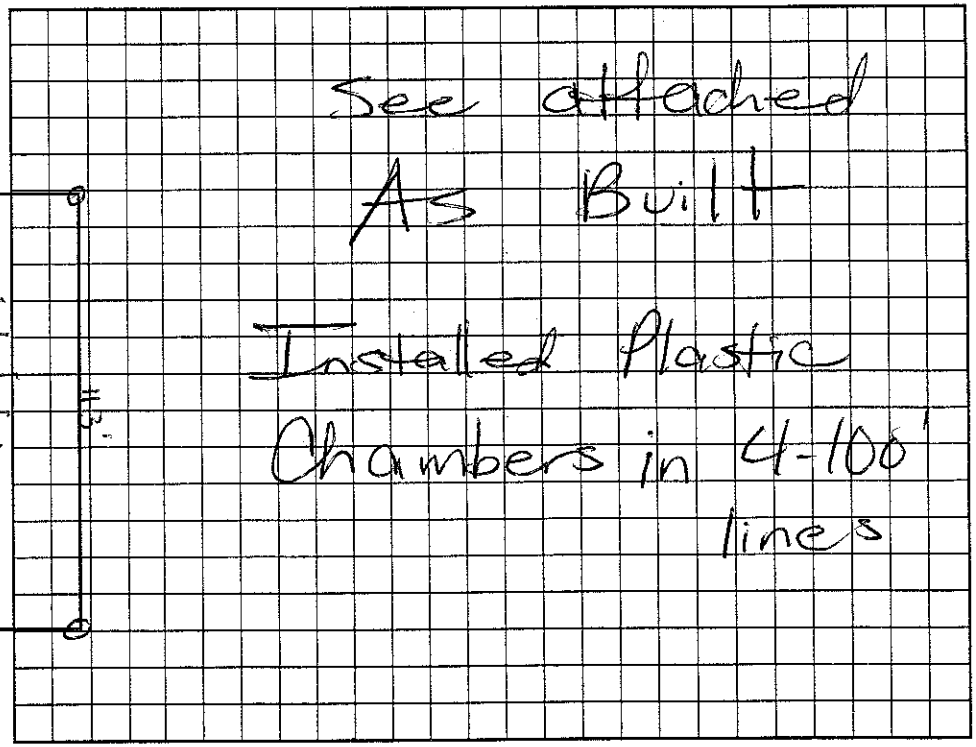


Permit can be suspended or revoked if any false information is supplied toward securing the permit/any unauthorized changes are made to the site/any unauthorized changes are made in the installation of the system. Improvement Permit with plat valid without expiration. Improvement Permit with site plan valid for sixty months. Authorization to Construct is valid for a period equal to that of Improvement Permit – not to exceed sixty months.

Signed: date 1/29/01

Improvement Permit by: date 1/10/01

Authorization to Construct by: date 6/21/04

Installed by: Craig Thompson RS

Operation Permit by: Mandy Dolan RS date 5/6/05

Existing System Inspection by: date

HEALTH DEPT. COPY: WHITE OWNER COPY (FINAL): YELLOW OWNER COPY (INITIAL): PINK