(9:30)

IREDELL COUNTY HEALTH DEPARTMENT

STATESVILLE 704-878-5305 MOORESVILLE 704-664-5281

IMPROVEMENT PERMIT / AUTHORIZATION TO CONSTRUCT / OPERATION PERMIT / EXISTING SYSTEM INSPECTION

PERMIT# D93018 PIN# ~~4679 D 59878 AP~~ 4679-11-3740 DATE 1/29/01

OWNER OR CONTRACTOR BEECHWOOD PARTNERS // New Concept Dev. PHONE: Business 664-9080 Home

ADDRESS 225 ROLLING HILLS RD MOORESVILLE NC 28117

LOCATION 801 N- TL TRIPLETT RD - TL MALLARDWOOD - TL WOODBINE ON LT

SUBDIVISION BEECHWOOD EST BLOCK / SECTION LOT 28 LOT AREA .721C SITE CLASS. BS DESIGN FLOW 360 GPD L.T.A.R. .3 gal/ft²

Septic Tank: 1000 Gallons; STB 1012 Date 9/8/01

Pump Tank: Gallons; PT Date

Pump Make: Model Serial No.

Nitrification Field: No Fields 1 Square Feet 900 Linear Feet 200

No Lines ~~4 @ 75'~~ Trench Width 36" Max Trench Bottom Depth 36" Gravel Depth N/A

☑ New System ☐ Repair System Type: I, II, III, IV, V, VI

System Description: GRAVITY 750G REDUCTION

Repair System Description: SAME

Maintenance Agreement Required: ☐ Yes ☑ No

☑ House/Mod. Home No. Bedrooms 3

☐ Mobile Home No. Bathrooms 2

☐ Business No. Employees

☐ Other


☐ Slab ☑ Crawl Space ☐ Basement w/plumbing ☐ Basement wo/plumbing

Water Supply: ☑ Individual ☐ Public ☐ Community


Comments:/Conditions: 4@75'

Comments:/Conditions:

INITIAL SITE SKETCH 1"=50'

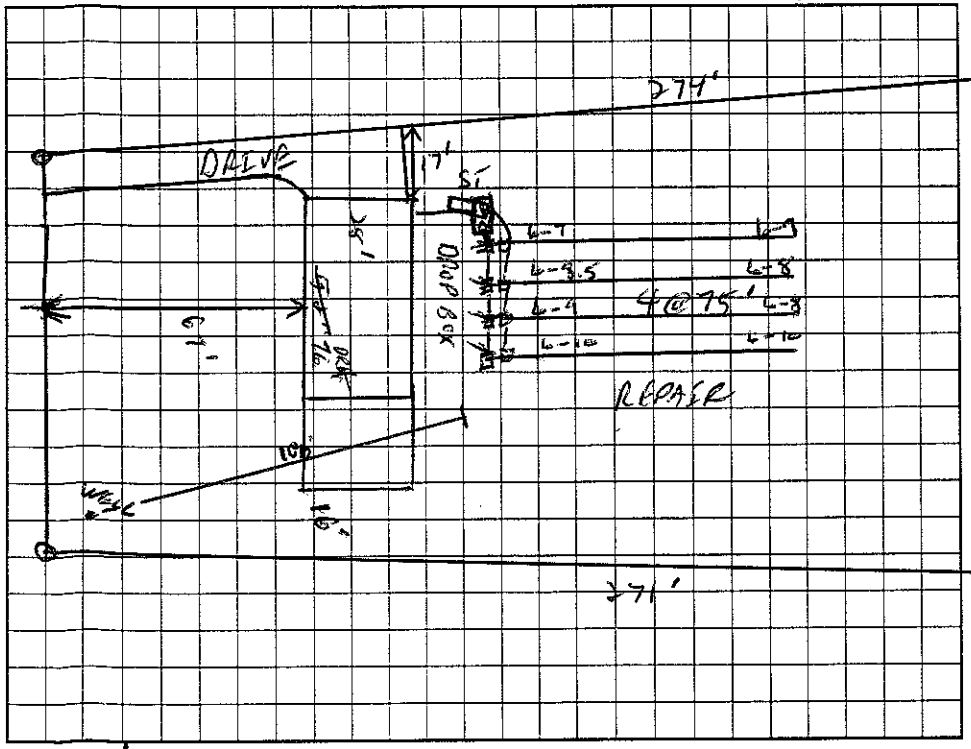

AS BUILT SKETCH

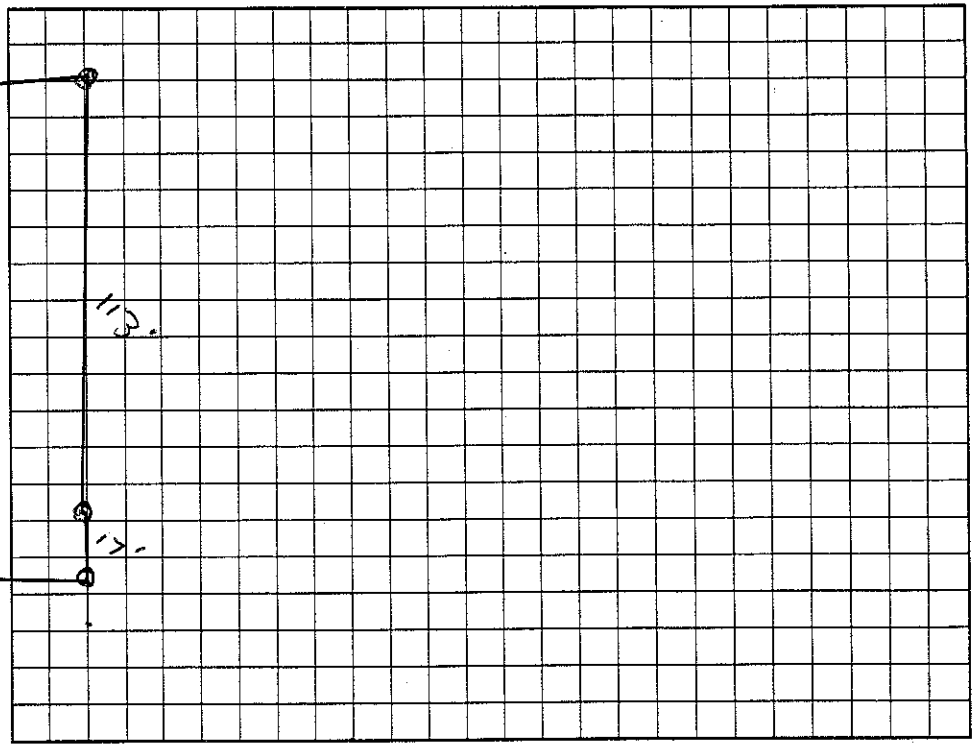

Permit can be suspended or revoked if any false information is supplied toward securing the permit/any unauthorized changes are made to the site/any unauthorized changes are made in the installation of the system. Improvement Permit with plat valid without expiration. Improvement Permit with site plan valid for sixty months. Authorization to Construct is valid for a period equal to that of Improvement Permit – not to exceed sixty months.

Signed: Mark E Mc... date 1/29/01

Improvement Permit by: C. ... date 1/29/01

Authorization to Construct by: ... date 10-17-01

Installed by: A-1 Backhoe

Operation Permit by: Wesley Sparkes RS date 11/16/01

Existing System Inspection by: date

HEALTH DEPT. COPY: WHITE OWNER COPY (FINAL): YELLOW OWNER COPY (INITIAL): PINK