16[50] - 11[00]

IREDELL COUNTY HEALTH DEPARTMENT

STATESVILLE 704-878-5305 MOORESVILLE 704-664-5281

IMPROVEMENT PERMIT / AUTHORIZATION TO CONSTRUCT / OPERATION PERMIT / EXISTING SYSTEM INSPECTION

PERMIT# 93019 PIN# ~~4679-02-4878-PT~~ 4679-11-3844 DATE 1/29/01

OWNER OR CONTRACTOR BEECHWOOD PARTNERS (EDWARD J. MORRIS) PHONE: Business 664-9050 Home

ADDRESS 225 ROLLING HILLS RD. MOORESVILLE NC 28117

LOCATION 801 N- TL TRIPLETT RD- TL MALLARDWOOD - TL WOODBINE - ON LT

SUBDIVISION BEECHWOOD EST. BLOCK / SECTION LOT 29 LOT AREA 1.86 AC SITE CLASS. RS DESIGN FLOW 360GPD L.T.A.R. .30 T/FT2

Septic Tank: 1000 Gallons; STB 317 Date 5/26/01
Pump Tank: Gallons; PT Date
Pump Make: Model Serial No.
Nitrification Field: No Fields 1 Square Feet 900 Linear Feet 300'
No Lines 3@100' Trench Width 36" Max Trench Bottom Depth 36" Gravel Depth N/A

☒ ~~New System~~ ☐ Repair System Type: I, II, III, IV, V, VI
System Description: GRAVITY 25% REDUCTION
Repair System Description: SAME
Maintenance Agreement Required: ☐ Yes ☒ ~~No~~


☒ ~~House/Mod. Home~~ No. Bedrooms 3
☐ Mobile Home No. Bathrooms 2
☐ Business No. Employees
☐ Other
☐ Slab ☐ ~~Crawl Space~~ ☐ Basement w/plumbing ☐ Basement wo/plumbing

Water Supply:
☒ ~~Individual~~
☐ Public
☐ Community


Comments:/Conditions:

Comments:/Conditions:

INITIAL SITE SKETCH 1" = 50'

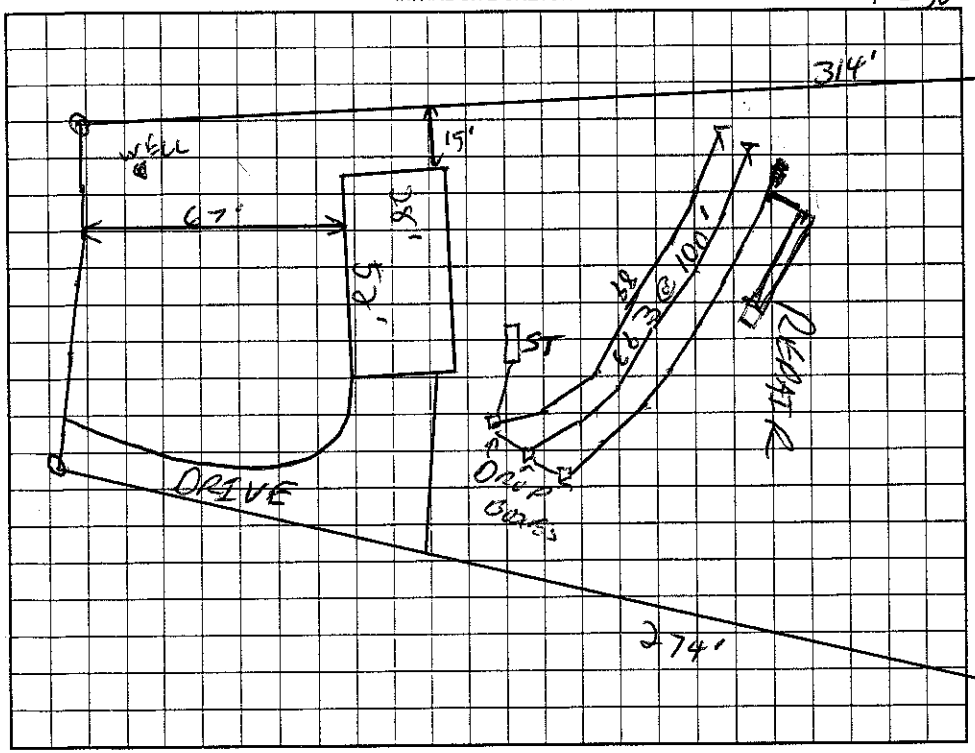

AS BUILT SKETCH

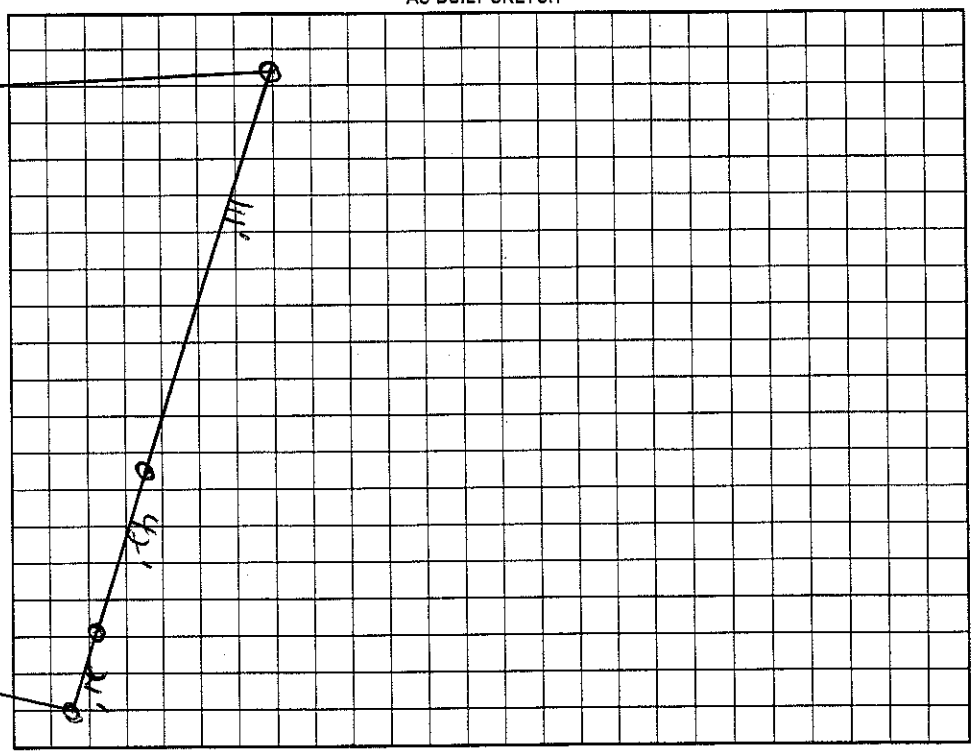

Permit can be suspended or revoked if any false information is supplied toward securing the permit/any unauthorized changes are made to the site/any unauthorized changes are made in the installation of the system. Improvement Permit with plat valid without expiration. Improvement Permit with site plan valid for sixty months. Authorization to Construct is valid for a period equal to that of Improvement Permit – not to exceed sixty months.

Signed: [signature] date 1/29/01

Improvement Permit by: [signature] RS date 1/29/01

Authorization to Construct by: Wesley Sparks RS. date 6/21/01

Installed by: Marty Tucker

Operation Permit by: Wesley Sparks RS. date 6/22/01

Existing System Inspection by: date

HEALTH DEPT. COPY: WHITE OWNER COPY (FINAL): YELLOW OWNER COPY (INITIAL): PINK