IREDELL COUNTY HEALTH DEPARTMENT

Statesville Phone TR 3-7271 Mooresville Phone NO 3-1271

PERMIT TO INSTALL SEPTIC TANK

Permit No. 4674-11-8635 Permit Date 4 April 1966

Owner Harold Cline Address Mooresville, NC

Installed By Carl Dockery Address Mooresville NC


Location of Property Rear of Edward Emery

Tank		Capacity		Length of Lines		Fixtures	
Block	( )	1000	(✓)	225'	(✓)	No. of Baths	( )
Precast	(✓)	1250	( )	250'	( )	Dishwasher	( )
		1500	( )	Other		Garbage Grdr.	( )
		Other				Other	

NOTIFY HEALTH DEPARTMENT AT LEAST EIGHT HOURS BEFORE TANK IS TO BE INSPECTED.

Final Inspection 4 April 1966 Approved (✓) Disapproved ( )

Remarks

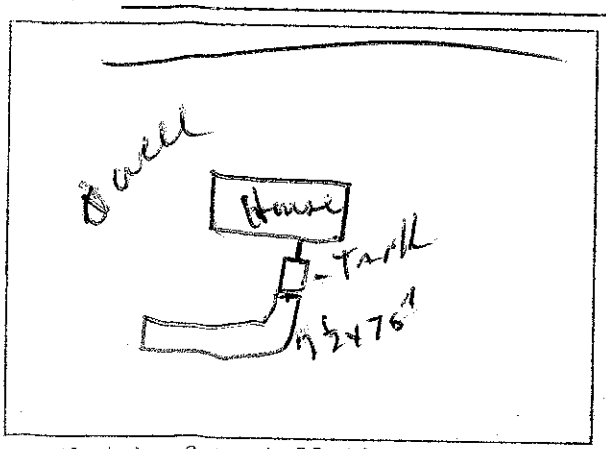

Sketch of Installation

Ray R. Scoggins RS

Sanitarian