4679118635

IREDELL COUNTY HEALTH DEPARTMENT

STATESVILLE 704-878-5305 MOORESVILLE 704-664-5281

IMPROVEMENT PERMIT / CERTIFICATE OF COMPLETION / OPERATION PERMIT / EXISTING SYSTEM INSPECTION

PROPERTY DESCRIPTION NO. Repair DATE 3/8/95 TAX MAP NO. Repair Watershed: ☐ Yes ☐ No

OWNER OR CONTRACTOR Hal Smith PHONE: Business Home 663-0102

ADDRESS 225 Triplett Rd. Mooresville

LOCATION 80 N to Triplett, 2nd house on L

SUBDIVISION NIA BLOCK / SECTION LOT LOT AREA SITE CLASS. DESIGN FLOW 360 L.T.A.R.

Septic Tank: 2 comp Gallons; STB 794 Ballenger Date 5-15-95

Pump Tank: Gallons; PT Date

Pump Make: Model Serial No.

Nitrification Field: No Fields 1 Square Feet 600 Linear Feet 1200

No Lines 2 Trench Width 36" Max Trench Bottom Depth 36" Gravel Depth 12-14"

☐ New System ☑ Repair System Type: I II III IV V VI

System Description:

Repair System Description:

Maintenance Agreement Required: ☐ Yes ☐ No

☑ House/Mod. Home No. Bedrooms 3

☐ Mobile Home No. Bathrooms 2

☐ Business No. Employees

☐ Other

☐ Slab ☐ Crawl Space ☐ Basement w/plumbing ☐ Basement wo/plumbing

Water Supply: ☑ Individual ☐ Community ☐ Public Submerged

Comments:


100' x 31 — 10N CONTOUR

DBOX

100' x 31

Comments: tank replaced due to poor condition D box not to feeld lines

INITIAL SITE SKETCH

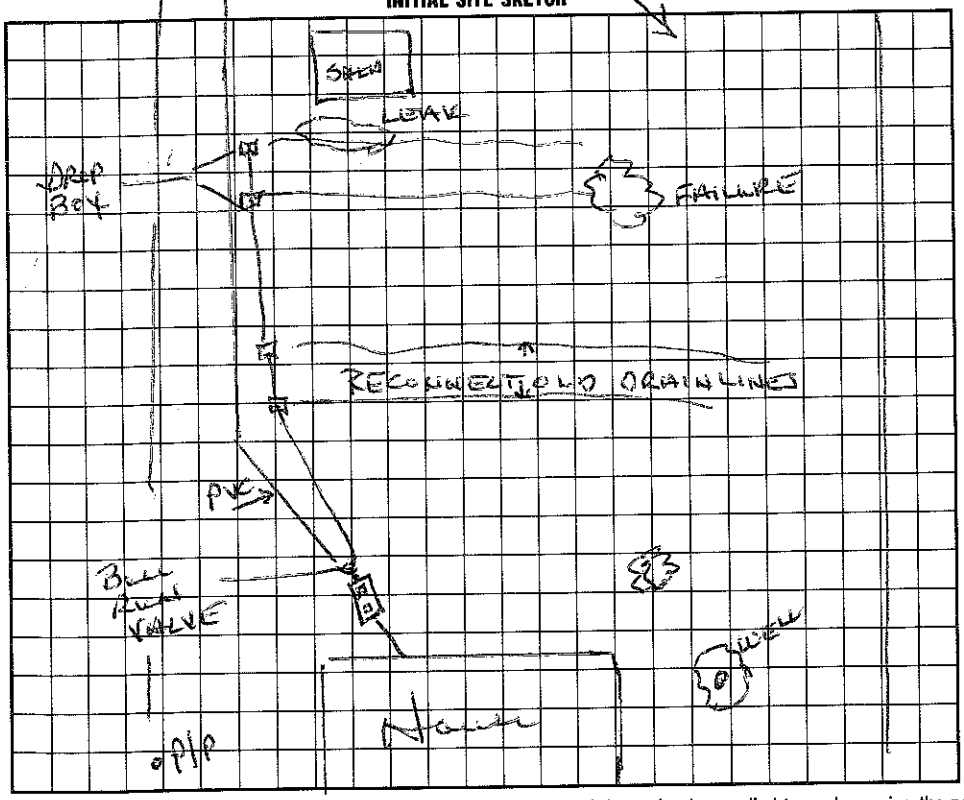

AS BUILT SKETCH

I understand that this permit can be suspended or revoked if any false information is supplied toward securing the permit/any unauthorized changes are made to the site/any unauthorized changes are made in the installation of the system. Improvement Permit is valid for 60 months from date of issuance.

Signed:

Improvement Permit by: Wesley Sparks RS. date 3/8/95

Existing System Inspection by: date

Installed by: Larry Beam

Certificate of Completion by: RS date 7-13-95

Operation Permit by: date

HEALTH DEPT. COPY: WHITE INSPECTION COPY (FINAL): GREEN OWNER COPY (FINAL): YELLOW INSPECTION COPY (INITIAL): PINK OWNER COPY (INITIAL): GOLD