2:00 828-241-2445 10:30

IREDELL COU[illegible] HEALTH DEPARTMENT - *ENVIRONMENTAL HEALTH* ☐ STATESVILLE OFFICE 704-878-5305 ☒ MOORESVILLE OFFICE 704-664-528[illegible]

IMPROVEM[illegible] PERMIT / AUTHORIZATION TO CONSTRUCT / OPERATION PERMIT / EXISTING SYSTEM INSPECTION

PERMIT # 142449 PIN # 4679-12-1044 DATE 8-16-11

OWNER DELORES GULLICK APPLICANT: ERIC WARD PHONE: Home/Cell # Business #

SITE ADDRESS 107 Woodbine Court OWNER/APPLICANT ADDRESS

SITE DIRECTIONS Sol. TRIPLET, BEECHWOOD, MALLARD WOOD

SUBDIVISION BEECHWOOD EST BLOCK / SECTION LOT # 51 LOT AREA .89Ac DESIGN FLOW 360 L.T.A.R. .3

Septic Tank 1000 Gallons: STB 760 Date 3-25-11 ☒ New System ☐ Repair ☐ Expansion System Type I II III IV V VI

Pump Tank Gallons: PT Date System Description: 25% Red

Pump Make Model Serial # Repair System Description: SAME

No. Nitrification Fields: 1 No. Lines 4 Linear Feet 300' Maintenance Agreement Required ☐ YES ☒ NO

Trench Width 36" Max. Trench Bottom Depth 36" Gravel Depth ☒ GRAVITY ☐ PRESSURE

☒ Residence No. Bedrooms 3 ☐ Business No. Persons ☐ Other No. Employees ☐ Slab ☐ Crawl Space ☐ Basement w/plumbing ☐ Basement w/o plumbing


Water Supply: ☒ Private ☐ Public ☐ Community

Comments / Conditions


* Well & home NOT on site at time of inspection. Installed Quick 4

Installed drainlines essentially as drawn; ST to side of Home

INITIAL SITE SKETCH

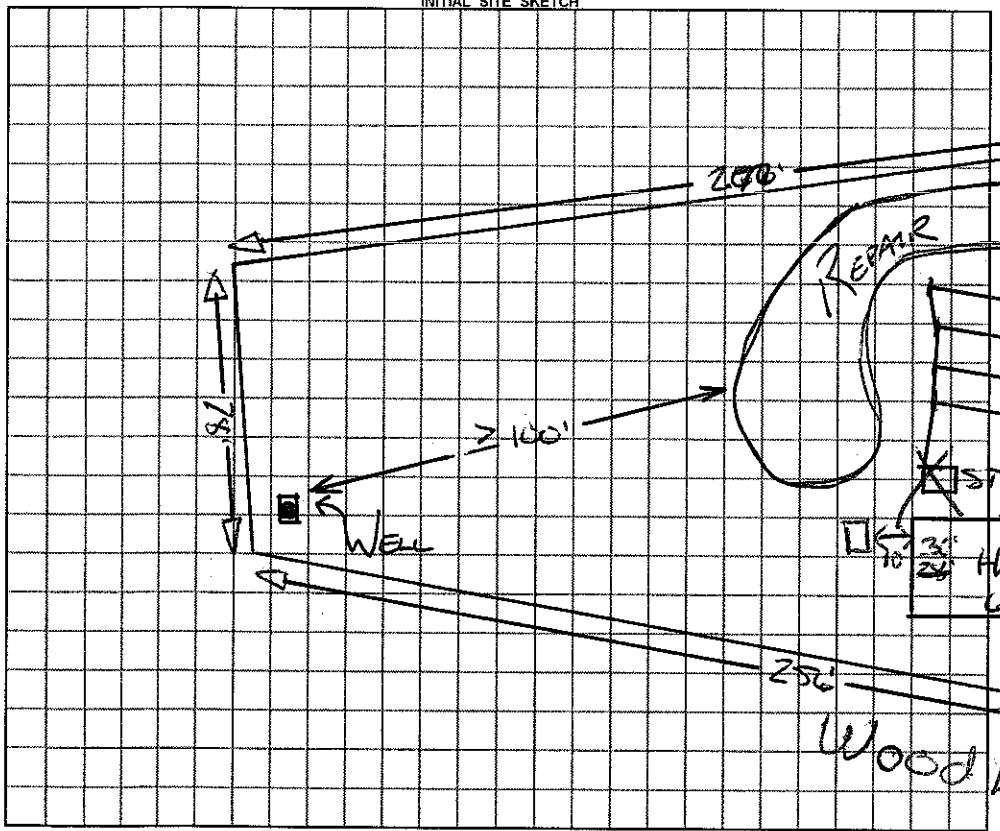

AS BUILT SKETCH

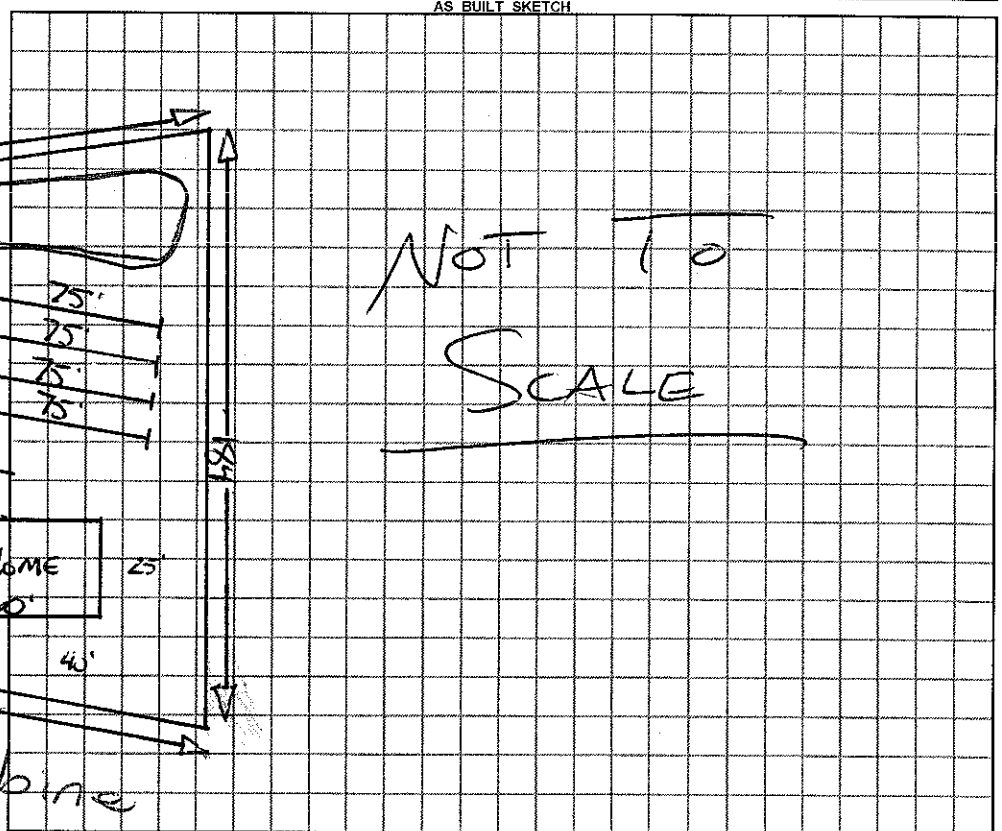

Permit can be suspended or revoked if any false information is supplied toward securing the permit / any unauthorized changes are made to the site / any unauthorized changes are made in the installation of the system.

☐ ***IMPROVEMENT PERMIT*** with plat valid without expiration. ☐ ***IMPROVEMENT PERMIT*** with ~~plat valid without expiration.~~ site plan valid 60 mo. ☐ ***AUTHORIZATION TO CONSTRUCT*** valid for period equal to IMPROVEMENT PERMIT--not to exceed 60 mo.

Owner / Applicant Signature: Dennis Gullick Date 8-17-11 Installed by: A-1 Backhoe RS

IMPROVEMENT PERMIT by: REHS Date 8-16-11 OPERATION PERMIT by: REHS Date 8/18/2011

AUTHORIZATION TO CONSTRUCT by: REHS Date 8-16-11 Existing System Inspected by: REHS Date

YOU SHOULD CONTACT A LOCATOR SERVICE PRIOR TO ANY EXCAVATION

White Copy – Environmental Health YELLOW COPY (Final) Owner / Applicant PINK COPY (Initial) Owner / Applicant