IREDELL COUNTY HEALTH DEPARTMENT

STATESVILLE 704-878-5305 MOORESVILLE 704-664-5281

50.00 Paid 2:00

IMPROVEMENT PERMIT / AUTHORIZATION TO CONSTRUCT / OPERATION PERMIT / EXISTING SYSTEM INSPECTION

PERMIT# 93023 PIN# 4679 02 9878 pt. 4679-12-2378 DATE 3/21/03

OWNER OR CONTRACTOR MELISSA SINCLAIR PHONE: Business Home 528-9336

ADDRESS 127 MALLARDWOOD DR MT ULLA, NC. 28125

LOCATION 801 N TL TRIPLETT RD TL MALLARDWOOD ON (L)

SUBDIVISION BEECH WOOD EST BLOCK / SECTION LOT 33 LOT AREA 1.6AC SITE CLASS. PS DESIGN FLOW 360 L.T.A.R. .3

Septic Tank: 1000 Gallons; STB 1012 Date 8/24/02
Pump Tank: 1000 Gallons; PT 17 Date 3/19/03
Pump Make: Myers Model 1/2HP Serial No.
Nitrification Field: No Fields 1 Square Feet 900 Linear Feet 300
No Lines 3@100' Trench Width 3' Max Trench Bottom Depth 3'

[X] New System [ ] Repair System Type: I, II, (III) IV, V, VI
System Description: PRES TO 25% REDUCTION
Repair System Description: LOW PRES - 16" PPBRS
Maintenance Agreement Required: [X] Yes [ ] No
Gravel Depth N/A [ ] Slab [X] Crawl Space [ ] Basement w/plumbing [ ] Basement wo/plumbing

[X] House/Mod. Home No. Bedrooms 3
[ ] Mobile Home No. Bathrooms 2
[ ] Business No. Employees
[ ] Other


Water Supply: [X] Individual [ ] Public [ ] Community

Comments:/Conditions:


Comments:/Conditions: OFFSITE EASEMENT FOR LOT 33
Lines & tanks checked by W.S
Pressure checked 4/16/03 MD

NOT TO SCALE

INITIAL SITE SKETCH

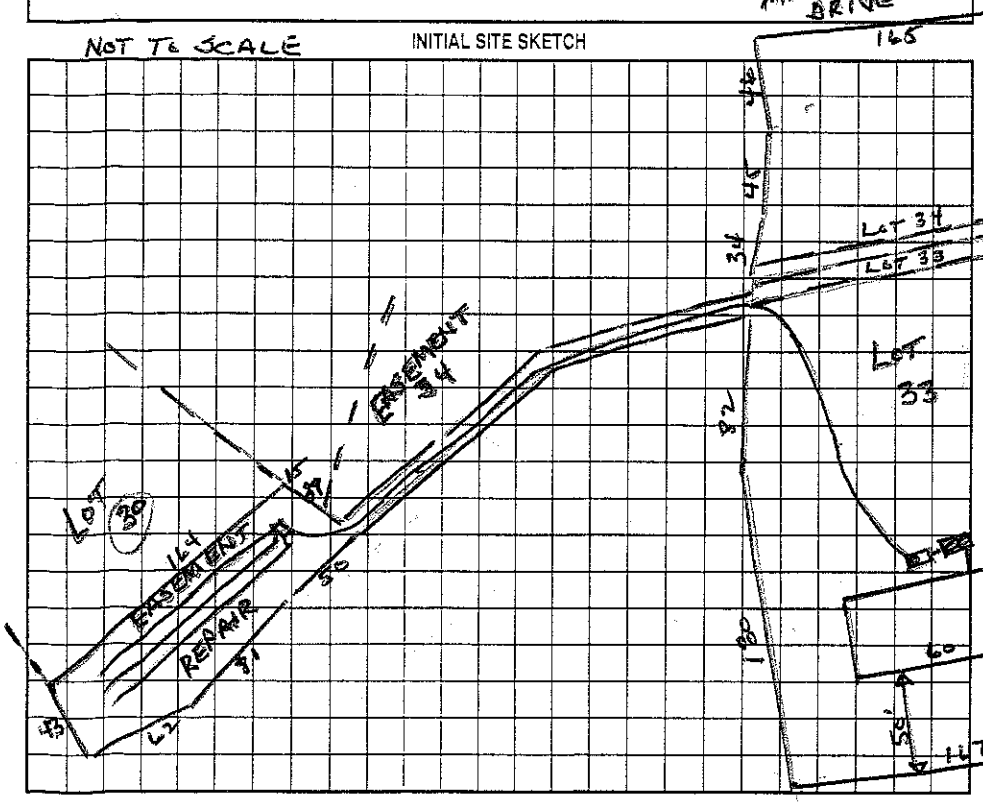

AS BUILT SKETCH

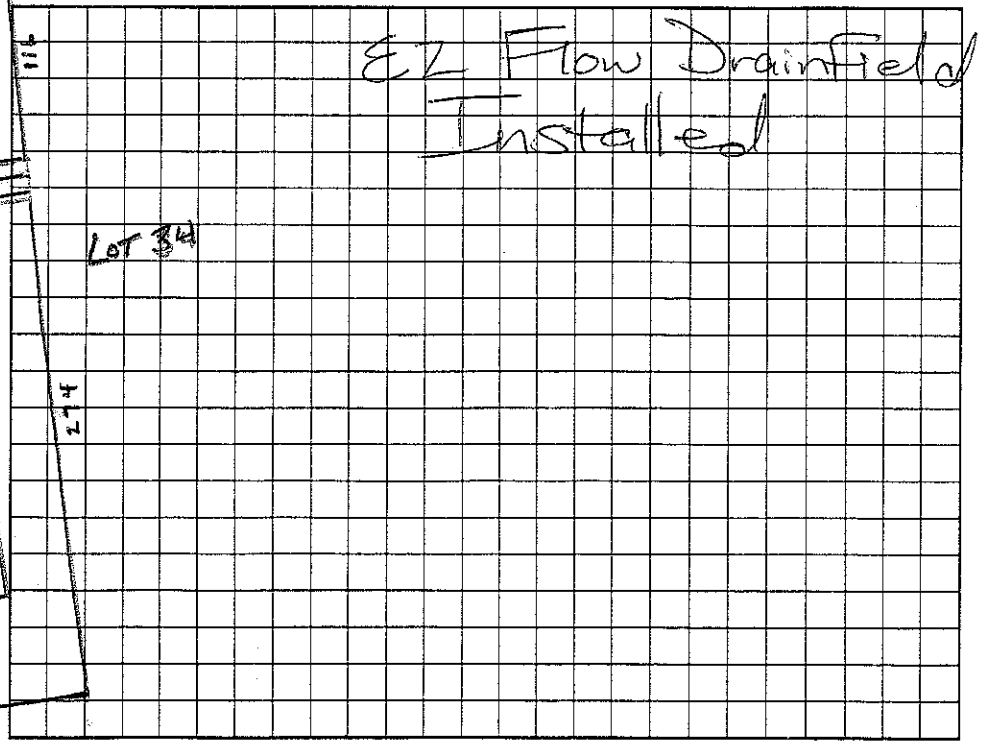

Permit can be suspended or revoked if any false information is supplied toward securing the permit/any unauthorized changes are made to the site/any unauthorized changes are made in the installation of the system. Improvement Permit with plat valid without expiration. Improvement Permit with site plan valid for sixty months. Authorization to Construct is valid for a period equal to that of Improvement Permit – not to exceed sixty months.

Signed: Jane B Graham date 3/24/03

Improvement Permit by: Wesley Sparks R.S. date 3/21/03

Authorization to Construct by: Wesley Sparks R.S. date 3/21/03

Installed by: Craig Thompson

Operation Permit by: Mark Dickson R.S. date 4/23/03

Existing System Inspection by: date

HEALTH DEPT. COPY: WHITE OWNER COPY (FINAL): YELLOW OWNER COPY (INITIAL): PINK