IREDELL COUNTY HEALTH DEPARTMENT

STATESVILLE 704-878-5305 MOORESVILLE 704-664-5281

IMPROVEMENT PERMIT / AUTHORIZATION TO CONSTRUCT / OPERATION PERMIT / EXISTING SYSTEM INSPECTION

PERMIT# 142456 PIN# 4679 12 2586 DATE 6/25/07

OWNER OR APPLICANT Beechwood Partners LLC PHONE: Business 704-664-9080 Home

ADDRESS 255 Rolling Hills Rd. Mooresville, NC. 28117

LOCATION 801 N TL Triplett Rd. TL Mallardwood Drive, 2ND lot on (L)

SUBDIVISION Beechwood Estates BLOCK SECTION LOT 34-37 LOT AREA 1.639 AC SITE CLASS. PS DESIGN FLOW 360 L.T.A.R. .3

Septic Tank: 1000 Gallons; STB 794 Date 1/21/08
Pump Tank: 1000 Gallons; PT 27 Date 1/8/08
Pump Make Goulds Model WE05511HH Serial No.
Nitrification Field: No Fields 1 Square Feet 600 Linear Feet 200
No Lines 4 @ 50' Trench Width 3' Max Trench Bottom Depth 3'

[X] New System [ ] Repair [ ] Expansion System Type: I II III (IV) V VI
System Description: LPP - 16" PPBPS
Repair System Description: SAME
Maintenance Agreement Required: [X] Yes [ ] No

[X] House/Mod. Home No. Bedrooms 3
[ ] Mobile Home No. Persons
[ ] Business No. Employees
[ ] Other


Water Supply: [X] Individual [ ] Public [ ] Community

Gravel Depth NO [ ] Gravity [X] Pressure [ ] Slab [X] Crawl Space [ ] Basement w/plumbing [ ] Basement wo/plumbing

Comments:/Conditions: House plan must be approved by IcHD.


NOT TO SCALE

INITIAL SITE SKETCH MALLARDWOOD DRIVE

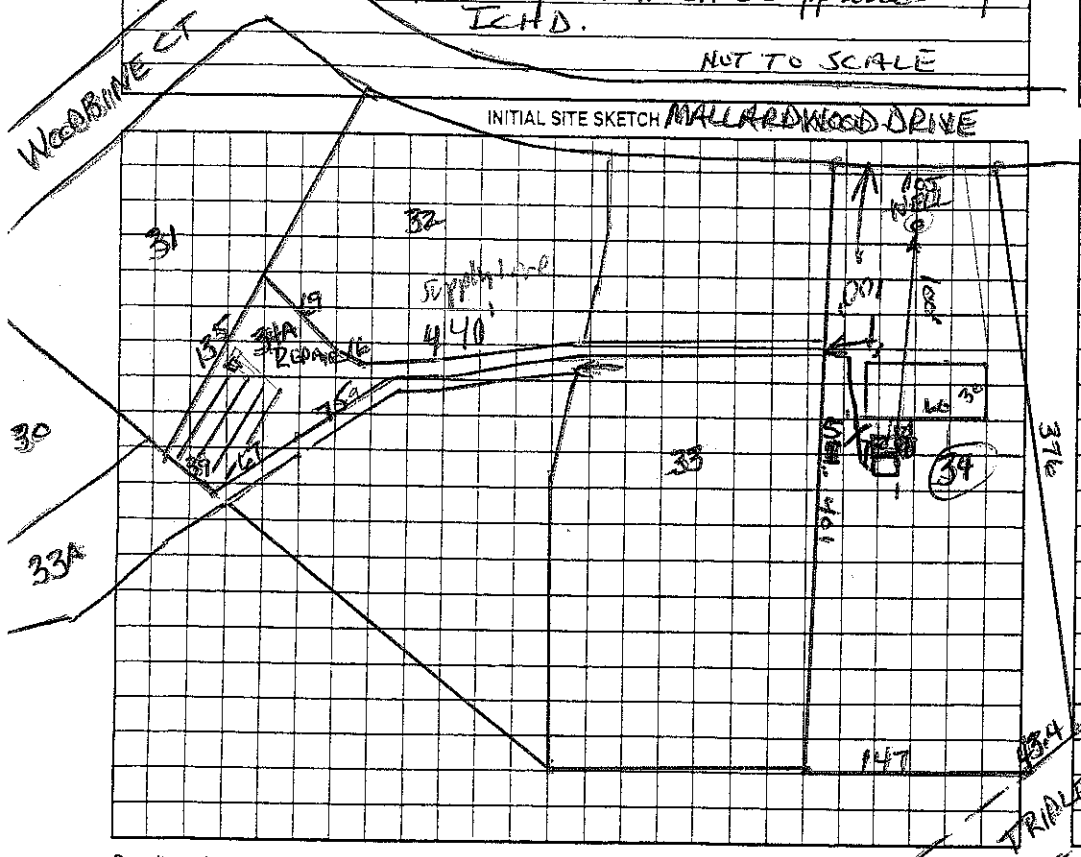

Comments:/Conditions: 3/16" holes in panel 3/11
Tanks checked 2/29/08
lines & valves checked 3/3/08 AS
3 PANEL Lines 67' each installed

AS BUILT SKETCH

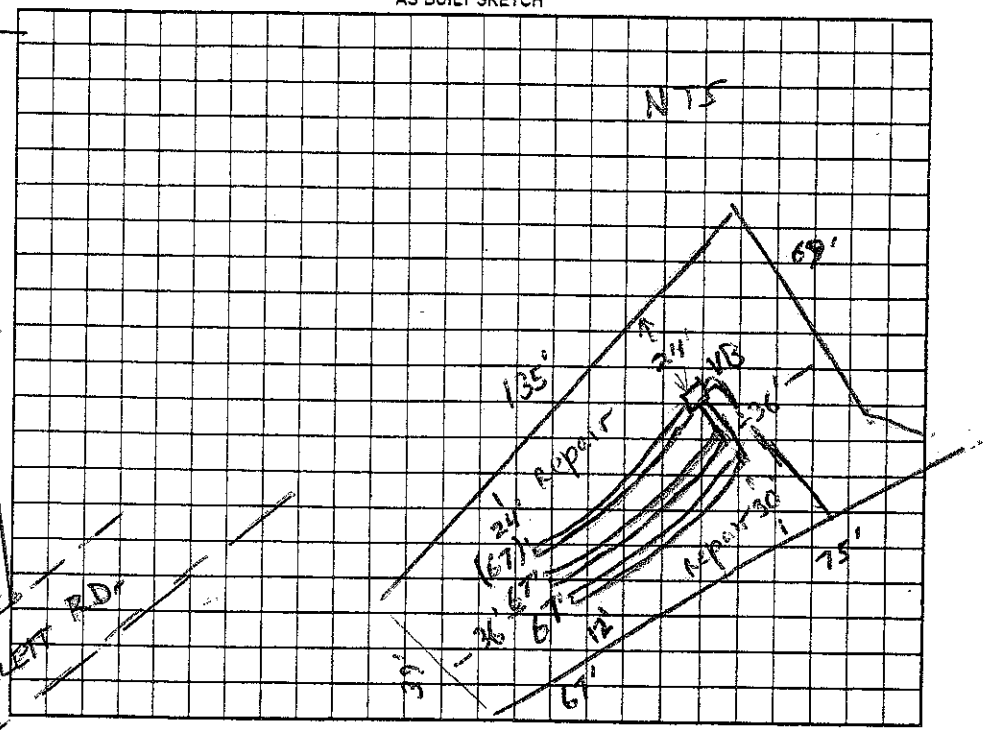

Permit can be suspended or revoked if any false information is supplied toward securing the permit/any unauthorized changes are made to the site/any unauthorized changes are made in the installation of the system. Improvement Permit with plat valid without expiration ☐ Improvement Permit with site plan valid for sixty months ☐ Authorization to Construct is valid for a period equal to that of Improvement Permit – not to exceed sixty months.

Signed: X date 6-28-07

Improvement Permit by: Wesley Sparks RS date 6/25/07

Authorization to Construct by: Wesley Sparks RS date 6/25/07

Installed by: Russel Williams

Operation Permit by: Anthony Coleman RS. date 4/3/08

Existing System Inspection by: date

HEALTH DEPT. COPY: WHITE OWNER COPY (FINAL): YELLOW OWNER COPY (INITIAL): PINK