IREDELL COUNTY HEALTH DEPARTMENT

Kilborne Farms

STATESVILLE 704-878-5305 MOORESVILLE 704-664-5281

IMPROVEMENT PERMIT / AUTHORIZATION TO CONSTRUCT / OPERATION PERMIT / EXISTING SYSTEM INSPECTION

PERMIT# 83556 PIN# 4679127865 PT 4679127656 DATE 5/17/2000

OWNER OR CONTRACTOR Spear Construction PHONE: Business 361-7518 Home

ADDRESS 607 Anderson Ave. Salisbury, NC 28144

LOCATION 801 N TL

SUBDIVISION Kilbourne BLOCK / SECTION LOT 9 LOT AREA 1.0 Acre SITE CLASS. PS DESIGN FLOW 360gpd L.T.A.R. .3

Septic Tank: Gallons; STB Date

Pump Tank: Gallons; PT Date

Pump Make: Model Serial No.

Nitrification Field: No Fields 1 Square Feet 900' Linear Feet 300'

No Lines 4 at 75' Trench Width 36" Max Trench Bottom Depth 36" Gravel Depth N/A

☒ New System ☐ Repair System Type: I, II, III, IV, V, VI

System Description: Pump - 25% Reduction

Repair System Description: Pump Panel

Maintenance Agreement Required: ☐ Yes ☒ No

☒ House/Mod. Home No. Bedrooms 3

☐ Mobile Home No. Bathrooms 2

☐ Business No. Employees

☐ Other


☐ Slab ☒ Crawl Space ☐ Basement w/plumbing ☐ Basement wo/plumbing

Water Supply: ☒ Individual ☐ Public ☐ Community


Comments/Conditions:

Comments/Conditions: Tanks & lines Checked 5/17/2000 (Plastic Chambers) (Driveway must hug property line (PL) to avoid Drainlines)

INITIAL SITE SKETCH Scale 1:50'

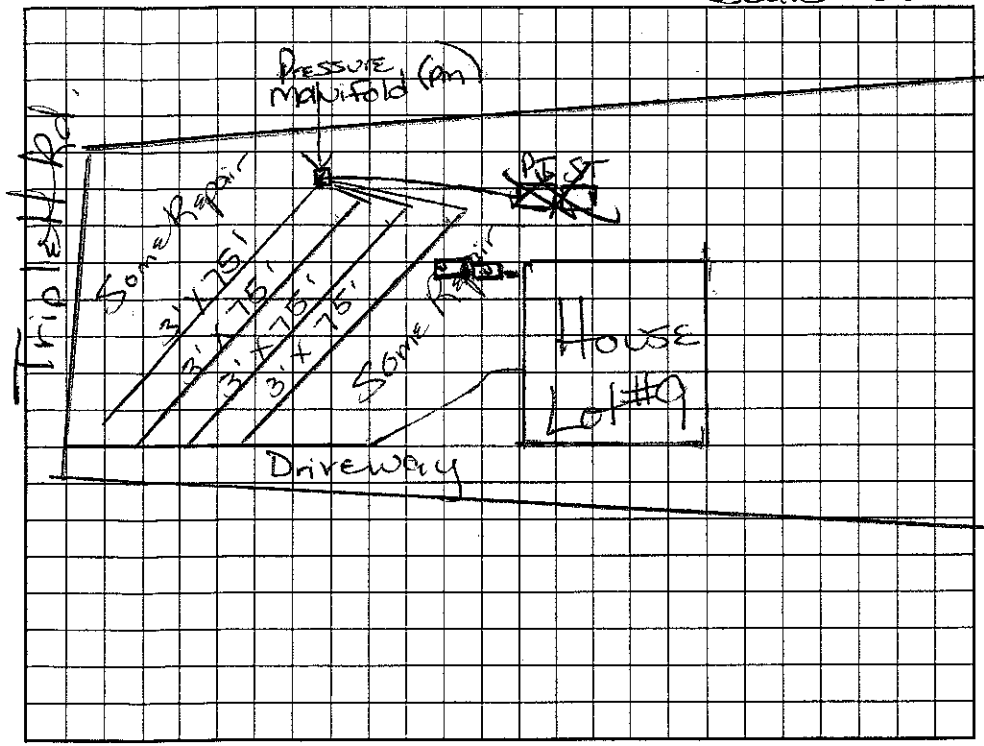

AS BUILT SKETCH

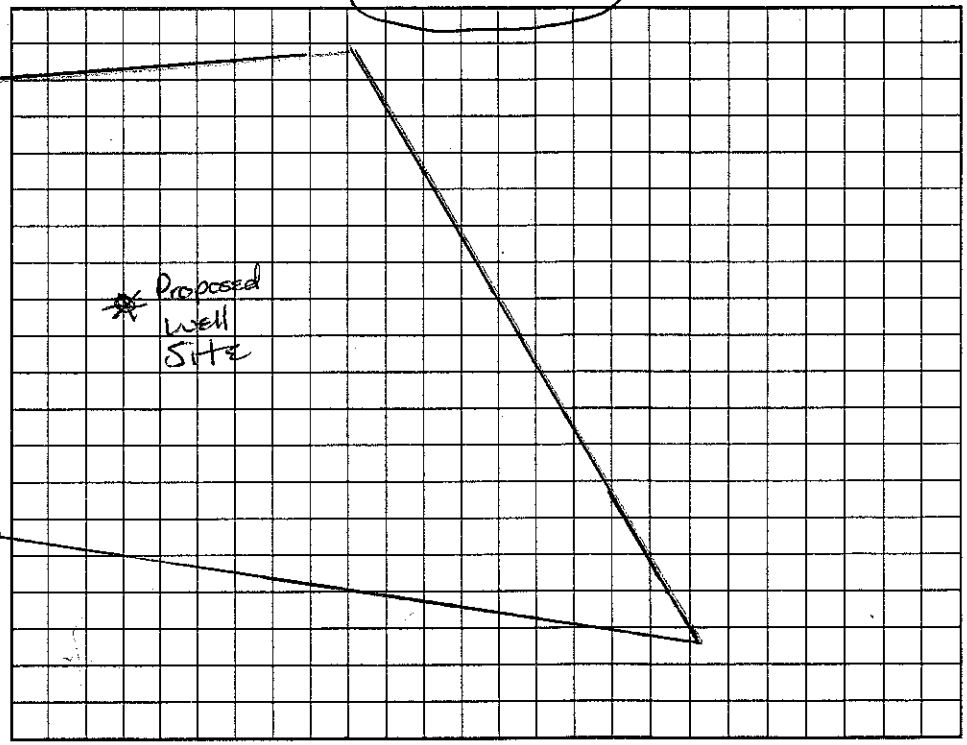

Permit can be suspended or revoked if any false information is supplied toward securing the permit/any unauthorized changes are made to the site/any unauthorized changes are made in the installation of the system. Improvement Permit with plat valid without expiration. Improvement Permit with site plan valid for sixty months. Authorization to Construct is valid for a period equal to that of Improvement Permit - not to exceed sixty months.

Signed: date 5/24/00 Installed by: Rowan Septic

Improvement Permit by: Maria H. Dotson date 5/22/00 Operation Permit by: Wesley Sparks RS. date 6/2/00

Authorization to Construct by: Maria H. Dotson date 5/22/00 Existing System Inspection by: date

HEALTH DEPT. COPY: WHITE OWNER COPY (FINAL): YELLOW OWNER COPY (INITIAL): PINK