4:00 or later

IREDELL COUNTY HEALTH DEPARTMENT

STATESVILLE 704-878-5305 MOORESVILLE 704-664-5281

IMPROVEMENT PERMIT / AUTHORIZATION TO CONSTRUCT / OPERATION PERMIT / EXISTING SYSTEM INSPECTION

PERMIT# 83554 PIN# 4679 12 7865 PT 4679 12 8459 DATE 8 9/7/99

OWNER OR CONTRACTOR SPEAR CONSTRUCTION PHONE: Business 361-7518 Home

ADDRESS 607 ANDERSON AVE SALISBURY NC 28144

LOCATION 801 N - TL TRIPLETT RD - 7TH LOT ON RT

SUBDIVISION KILBOURNE BLOCK / SECTION LOT 7 LOT AREA 1.0 AC SITE CLASS. PS DESIGN FLOW 360 GPD L.T.A.R. .30 GPD/FT2

Septic Tank: 1000 Gallons; STB 825 Date 3/4/80

Pump Tank: 1000 Gallons; PT 802 Date 7-6/80

Pump Make: Model Serial No.

Nitrification Field: No Fields 1 Square Feet 1200 Linear Feet 400

No Lines 5@80' Trench Width 36" Max Trench Bottom Depth 36"-40" Gravel Depth 12"

☑ New System ☐ Repair System Type: I, II, III, IV, V, VI

System Description: PUMP CONVENTIONAL C

Repair System Description: PUMP 25% REDUCTION

Maintenance Agreement Required: ☐ Yes ☑ No

☑ House/Mod. Home No. Bedrooms 3

☐ Mobile Home No. Bathrooms 2

☐ Business No. Employees

☐ Other

☐ Slab ☑ Crawl Space ☐ Basement w/plumbing ☐ Basement wo/plumbing


Water Supply: ☑ Individual ☐ Public ☐ Community

Comments:/Conditions:


12" to 14" OF SOIL SHALL BE REMOVED TO GET 36" TRENCH BOTTOM ON PS ~~SOIL~~ SAPROLITE.

Comments:/Conditions:

INITIAL SITE SKETCH 1"=50'

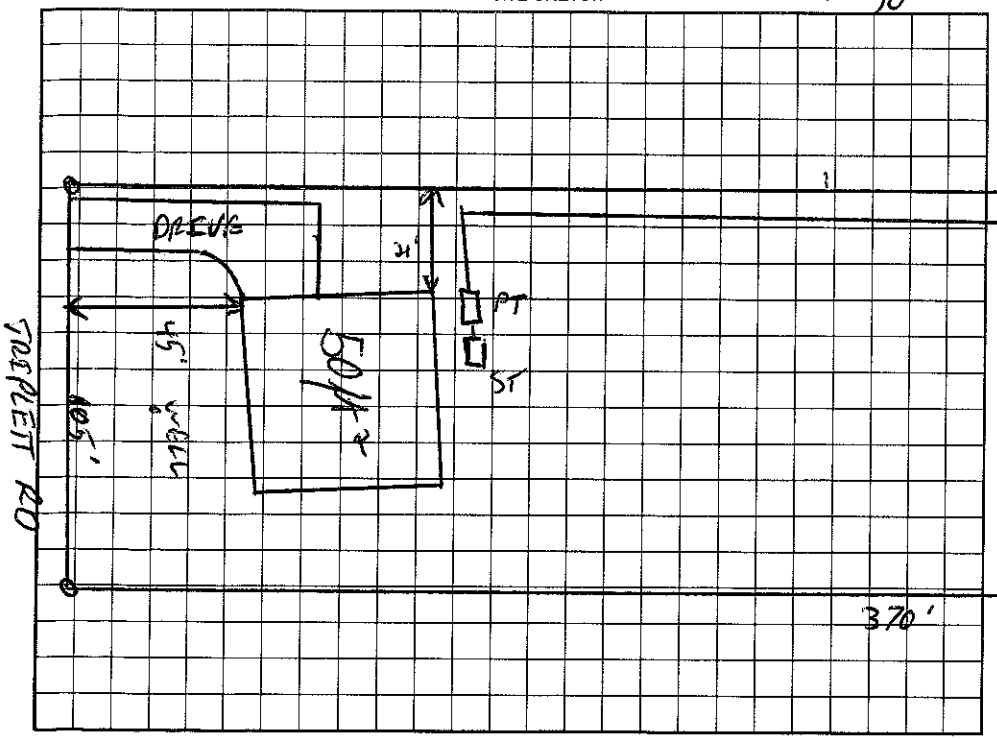

AS BUILT SKETCH

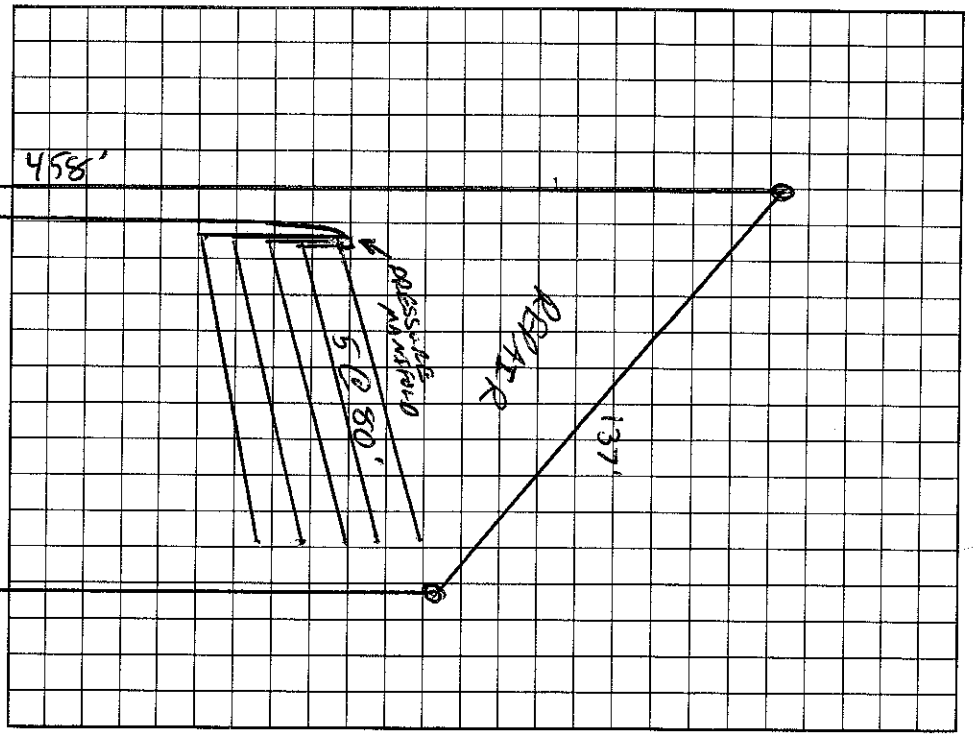

Permit can be suspended or revoked if any false information is supplied toward securing the permit/any unauthorized changes are made to the site/any unauthorized changes are made in the installation of the system. Improvement Permit with plat valid without expiration. Improvement Permit with site plan valid for sixty months. Authorization to Construct is valid for a period equal to that of Improvement Permit – not to exceed sixty months.

Signed: date 9/9/99

Improvement Permit by: date 9/9/99

Authorization to Construct by: date 9/9/99

Installed by:

Operation Permit by: date 4/26/00

Existing System Inspection by: date

HEALTH DEPT. COPY: WHITE OWNER COPY (FINAL): YELLOW OWNER COPY (INITIAL): PINK