4679134604

IREDELL COUNTY HEALTH DEPARTMENT

STATESVILLE 704-878-5305 MOORESVILLE 704-664-5281

IMPROVEMENT PERMIT / CERTIFICATE OF COMPLETION / OPERATION PERMIT / EXISTING SYSTEM INSPECTION

PROPERTY DESCRIPTION NO. 17114 DATE 11/29/93 TAX MAP NO. 4C-C-7 Watershed: ☑ Yes ☐ No

OWNER OR CONTRACTOR C WAYNE ORBISON PHONE: Business _____ Home 663-4745

ADDRESS R+5 BOX 291 MOORESVILLE, NC. 28115

LOCATION MAZEPPA RD. X TRIPLETT RD. ON (L)

SUBDIVISION N/A BLOCK / SECTION _____ LOT _____ LOT AREA _____ SITE CLASS. P DESIGN FLOW ~~360~~ 330 L.T.A.R. .35

Septic Tank: 1000 Gallons; STB 358 Date 1/14/94

Pump Tank: _____ Gallons; PT _____ Date _____

Pump Make: _____ Model _____ Serial No. _____

Nitrification Field: No Fields ~~4~~ 3 Square Feet 960 Linear Feet 300

No Lines ~~4~~ 4 Trench Width 3' Max Trench Bottom Depth 36" Gravel Depth 12"

☐ New System ☐ Repair System Type: ☑ I, ☐ II, III, IV, V, VI

System Description: CONV - DROP BOXES

Repair System Description: _____

Maintenance Agreement Required: ☐ Yes ☐ No

☑ House/Mod. Home No. Bedrooms 3

☐ Mobile Home No. Bathrooms 2

☐ Business No. Employees _____

☐ Other _____


☐ Slab ☑ Crawl Space ☐ Basement w/plumbing ☐ Basement wo/plumbing

Water Supply: ☑ Individual ☐ Community ☐ Public

Comments:
ADDING CARPORT AND SCREEN PORCH ON REAR OF HOUSE

Comments:
Installed as shown

INITIAL SITE SKETCH

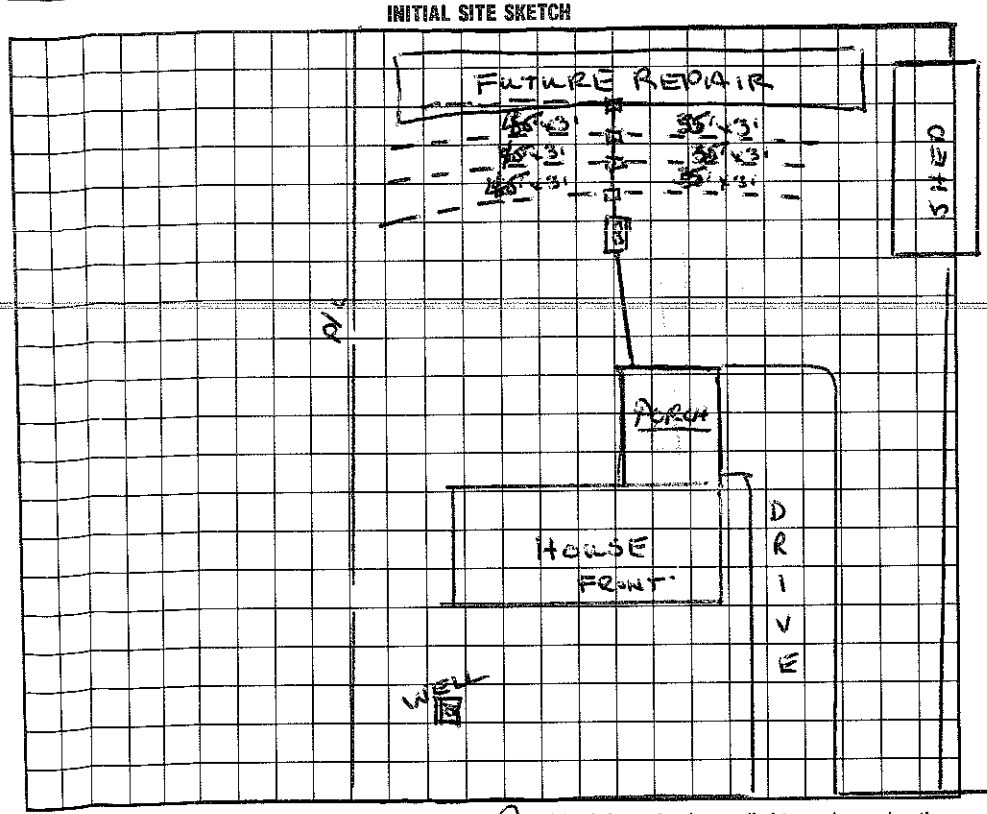

AS BUILT SKETCH

I understand that this permit can be suspended or revoked if any false information is supplied toward securing the permit/any unauthorized changes are made to the site/any unauthorized changes are made in the installation of the system. Improvement Permit is valid for 60 months from date of issuance. MAZEPPA RD.

Signed: C Wayne Orbison

Improvement Permit by: Wesley Sparks R.S. date 11/29/93

Existing System Inspection by: _____ date _____

Installed by: Wayne Orbison

Certificate of Completion by: Wesley Sparks R.S. date 3/8/94

Operation Permit by: _____ date _____

HEALTH DEPT. COPY: WHITE INSPECTION COPY (FINAL): GREEN OWNER COPY (FINAL): YELLOW INSPECTION COPY (INITIAL): PINK OWNER COPY (INITIAL): GOLD