11:30

IREDELL COUNTY HEALTH DEPARTMENT

STATESVILLE 704-878-5305 MOORESVILLE 704-664-5281

IMPROVEMENT PERMIT / AUTHORIZATION TO CONSTRUCT / OPERATION PERMIT / EXISTING SYSTEM INSPECTION

PERMIT# NA PIN # 4679 15 5055 DATE 7/7/09

OWNER or APPLICANT WM. "BILL" POSTON PHONE: Business Home:

OWNER or APPLICANT ADDRESS 2083 TRIPLETT RD. MOORESVILLE, NC. 28115

LOCATION/DIRECTIONS 2083 TRIPLETT RD., 1ST DRIVE ON (R)

SUBDIVISION BLOCK / SECTION LOT # LOT AREA DESIGN FLOW 360 L.T.A.R. .3

Septic Tank 1000 Gallons: STB Date

Pump Tank Gallons: P T Date

Pump Make Model Serial #

Nitrification Field No Fields 1 No Lines 3 Linear Feet 900

Trench Width 3' Max. Trench Bottom Depth 3' Gravel Depth NA

☐ New System ☒ Repair ☐ Expansion System Type I (II) III IV V VI

System Description:

Repair System Description: GR - 25% REDUCTION

Maintenance Agreement Required ☐ YES ☒ NO


☒ Residence No. Bedrooms 3 ☐ Business No. Persons ☐ Other No. Employees

☐ Slab ☐ Crawl Space ☐ Basement w/plumbing ☐ Basement w/o plumbing

Water Supply: ☒ Private ☐ Public ☐ Community

Comments / Conditions

INITIAL SITE SKETCH

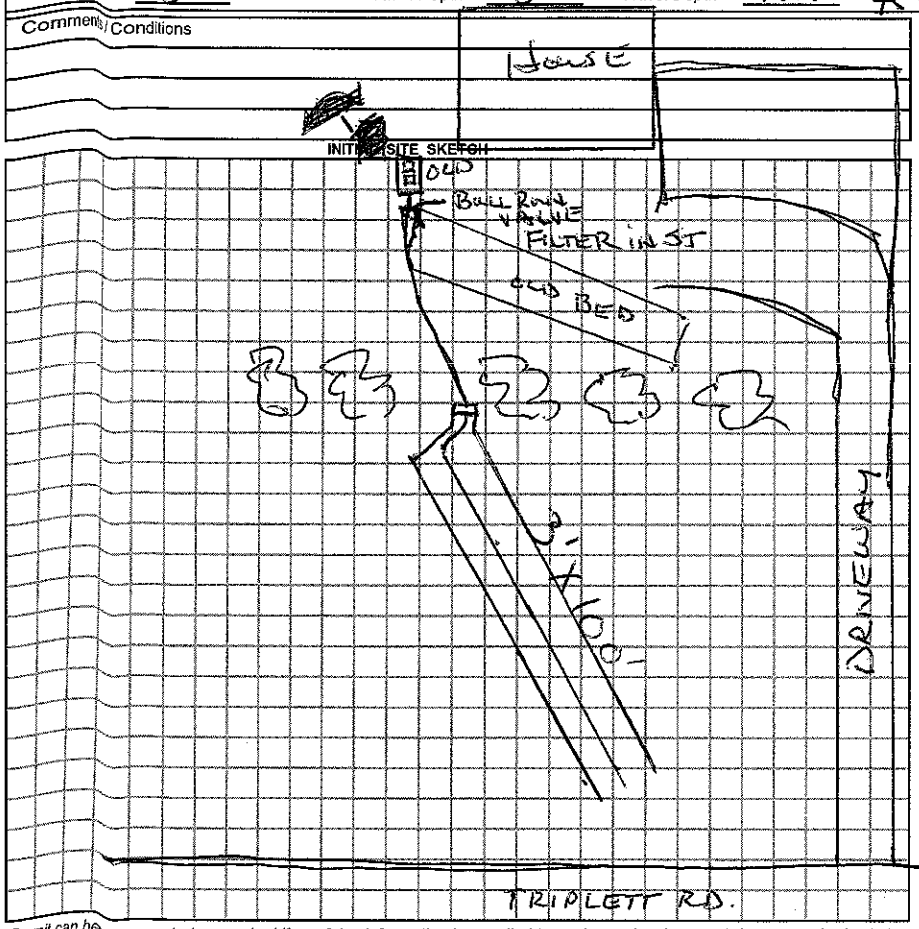

Comments / Conditions ST ~ 10-11 yrs
Installed Quick4 as drawn
Replaced old D-box for Exist System

AS BUILT SKETCH

Permit can be suspended or revoked if any false information is supplied toward securing the permit / any unauthorized changes are made to the site / any unauthorized changes are made in the installation of the system.

☐ IMPROVEMENT PERMIT w / plat valid without expiration. ☐ IMPROVEMENT PERMIT w / site plan valid for 60 mos. ☒ AUTHORIZATION TO CONSTRUCT valid for period equal to IMPROVEMENT PERMIT-not to exceed 60 mo.

Owner / Applicant Signature: [signature] Date 7/7/09

Improvement Permit by: Wesley Sparks RS. Date 7/7/09

Authorization to Construct by: Wesley Sparks RS. Date 7/7/09

YOU SHOULD CONTACT A LOCATOR SERVICE PRIOR TO ANY EXCAVATION.

Installed by: C. Wayne Orbison

Operation Permit by: Maid[illegible] RS Date: 7/9/09

Existing System Inspected by: Date:

WHITE COPY Environmental Health YELLOW COPY (Final) Owner / Applicant PINK COPY (Initial) Owner / Applicant

(2:30)

IREDELL COUNTY HEALTH DEPARTMENT

STATESVILLE 704-878-5305 MOORESVILLE 704-664-5281

IMPROVEMENT PERMIT / AUTHORIZATION TO CONSTRUCT / OPERATION PERMIT / EXISTING SYSTEM INSPECTION

PERMIT# REPAIR PIN# REPAIR DATE 5/11/98

OWNER OR CONTRACTOR HAZEL POSTON PHONE: Business Home 663-4733

ADDRESS 859 MEZEPPA RD. MOORESVILLE

LOCATION 801 N. TL TREPLETT RD. # 2083 TREPLETT RD

SUBDIVISION — BLOCK / SECTION — LOT — LOT AREA — SITE CLASS. PS DESIGN FLOW 360 L.T.A.R. —

Septic Tank: 1000-EXISTING Gallons; STB 794 Date 3/19/98

Pump Tank: Gallons; PT Date

Pump Make: Model Serial No.

Nitrification Field: No Fields 1 Square Feet 900 Linear Feet 75

No Lines 3@75' Trench Width 12' Max Trench Bottom Depth AS NEEDED Gravel Depth N/A

☐ New System ☑ Repair System Type: I, II, (III), IV, V, VI

System Description:

Repair System Description: GRAVITY CHAMBERS BED

Maintenance Agreement Required: ☐ Yes ☑ No OR HOS

☑ House/Mod. Home No. Bedrooms 3

☐ Mobile Home No. Bathrooms 2

☐ Business No. Employees

☐ Other

☐ Slab ☑ Crawl Space ☐ Basement w/plumbing ☐ Basement wo/plumbing

Water Supply: ☑ Individual ☐ Public ☐ Community


Comments:/Conditions: CUT OFF EXISTING SYSTEM

NEW SEPTIC TANK MAY NEED TO BE SET *(1000 GAL)*

Comments:/Conditions:

NEW TANK SET

INITIAL SITE SKETCH

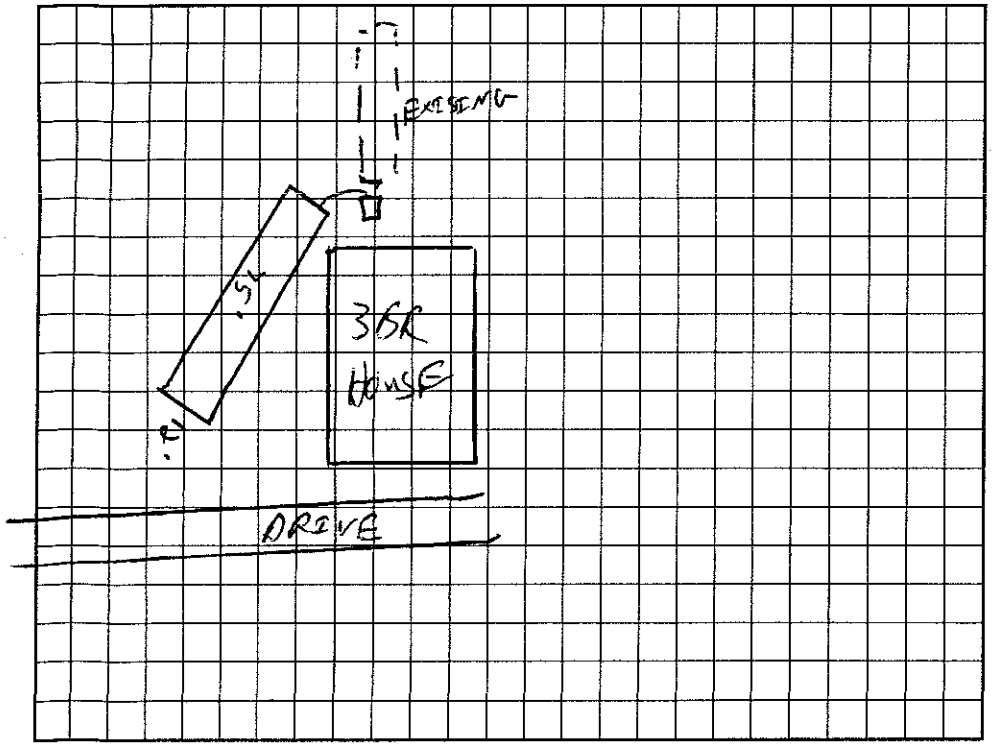

AS BUILT SKETCH

I understand that this permit can be suspended or revoked if any false information is supplied toward securing the permit/any unauthorized changes are made to the site/any unauthorized changes are made in the installation of the system. Improvement Permit with plat valid without expiration. Improvement Permit with site plan valid for sixty months. Authorization to Construct is valid for a period equal to that of Improvement Permit – not to exceed sixty months.

Signed: date

Improvement Permit by: date 5/11/98

Authorization to Construct by: date 5/11/98

Installed by: ORBISON

Operation Permit by: date 5/20/98

Existing System Inspection by: date

HEALTH DEPT. COPY: WHITE INSPECTION COPY (FINAL): GREEN OWNER COPY (FINAL): YELLOW INSPECTION COPY (INITIAL): PINK OWNER COPY (INITIAL): GOLD