IREDELL COUNTY HEALTH DEPARTMENT - *ENVIRONMENTAL HEALTH* ☐ STATESVILLE OFFICE 704-878-5305 ☐ MOORESVILLE OFFICE 704-664

IMPROVEMENT PERMIT / AUTHORIZATION TO CONSTRUCT / OPERATION PERMIT / EXISTING SYSTEM INSPECTION

PERMIT # 149032 PIN # 4679183502 DATE 1-13-2012

OWNER Jimmy Barton APPLICANT: PHONE: Home/Cell # 7046772495 Business #

SITE ADDRESS 1883 J Triplett Rd Mt. Ulla OWNER / APPLICANT ADDRESS

SITE DIRECTIONS Hwy 801 N TL Triplett on right 2nd house. PASS French Belk

SUBDIVISION BLOCK / SECTION LOT # Tract 1 LOT AREA 1.5Ac DESIGN FLOW 360 L.T.A.R. .3

Existing

Septic Tank 1600 Gallons: STB Date
Pump Tank Gallons: P T Date
Pump Make Model Serial #
No. Nitrification Fields: 1 No. Lines 4 Linear Feet 400'
Trench Width 36" Max. Trench Bottom Depth 36" Gravel Depth N/A

☐ New System ☐ Repair ☐ Expansion System Type I II III IV V VI
System Description: Existing Gravity - Conventional
Repair System Description: Grav. 25% to Reduct
Maintenance Agreement Required ☐ YES ☒ NO
☒ GRAVITY ☐ PRESSURE


☐ Residence No. Bedrooms
☐ Business No. Persons
☒ Other No. Employees
☒ Slab ☐ Crawl Space
☐ Basement w/plumbing ☐ Basement w/o plumbing

Water Supply
☒ Private
☐ Public
☐ Community


Comments / Conditions

Existing Septic System appears to be functioning okay at time of inspection. Detached Garage should not impact Septic System

INITIAL SITE SKETCH

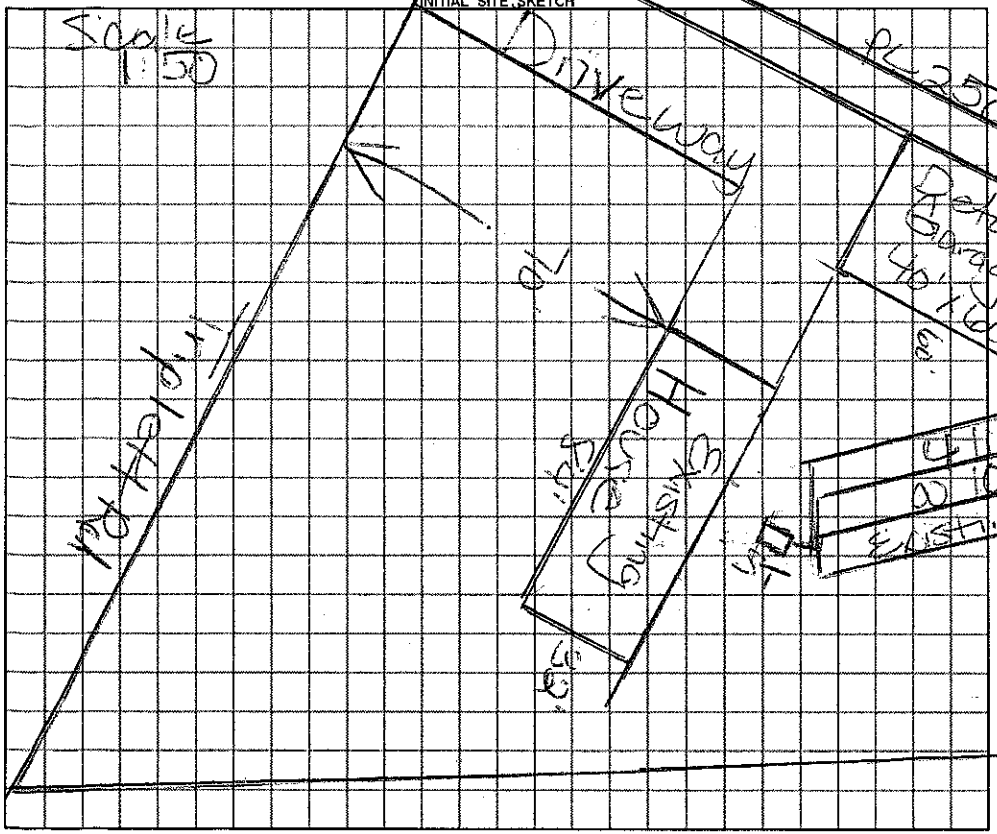

AS BUILT SKETCH

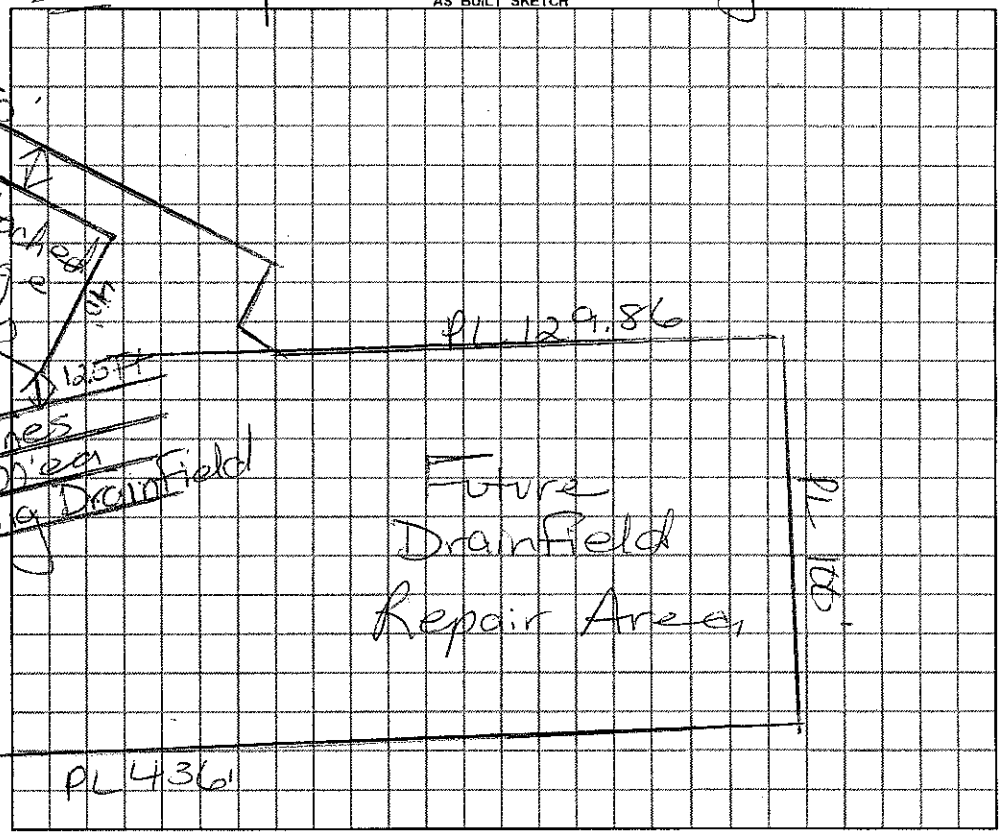

Permit can be suspended or revoked if any false information is supplied toward securing the permit / any unauthorized changes are made to the site / any unauthorized changes are made in the installation of the system.

☐ ***IMPROVEMENT PERMIT*** with plat valid without expiration. ☐ ***IMPROVEMENT PERMIT*** with ~~plat valid without expiration.~~ site plan valid 60 mo. ☐ ***AUTHORIZATION TO CONSTRUCT*** valid for period equal to IMPROVEMENT PERMIT--not to exceed 60 mo.

Owner / Applicant Signature: Jimmy Barton Date

IMPROVEMENT PERMIT by: REHS Date

AUTHORIZATION TO CONSTRUCT by: REHS Date

Installed by: Larry Beam 6/29/04

OPERATION PERMIT by: REHS Date

Existing System Inspected by: [signature] REHS Date 1/13/2012

YOU SHOULD CONTACT A LOCATOR SERVICE PRIOR TO ANY EXCAVATION

White Copy – Environmental Health YELLOW COPY (Final) Owner / Applicant PINK COPY (initial) Owner / Applicant