IREDELL COUNTY HEALTH DEPARTMENT

STATESVILLE 704-878-5305 MOORESVILLE 704-664-5281

IMPROVEMENT PERMIT / AUTHORIZATION TO CONSTRUCT / OPERATION PERMIT / EXISTING SYSTEM INSPECTION

PERMIT# 112857 PIN# 4679 18 5810.1 DATE 7/31/03

OWNER OR CONTRACTOR Samuel D. Ferguson PHONE: Business 704-663-0557 Home

ADDRESS 1328 Mt. Ulla Hwy. Mooresville, NC. 28115

LOCATION 801 N L Trapplat, mile and a half just past Confederate Rd. on (R)

SUBDIVISION BLOCK / SECTION LOT Tract 1 LOT AREA 1.5AC SITE CLASS: PS DESIGN FLOW 360 L.T.A.R. .3

Septic Tank: 1000 Gallons; STB/ 3/2 Date 5/23/04

Pump Tank: Gallons; PT Date

Pump Make: Model Serial No:

Nitrification Field: No Fields 1 Square Feet 1200 Linear Feet 400

No Lines 4@100' Trench Width 3' Max Trench Bottom Depth 3' Gravel Depth 12"

[X] New System [ ] Repair System Type: I, (II), III, IV, V, VI

System Description: GRAV - CONVENTIONAL

Repair System Description: GRAV - 25% Reduced

Maintenance Agreement Required: [ ] Yes [X] No

[X] House/Mod. Home No. Bedrooms 3

[ ] Mobile Home No. Bathrooms 2

[ ] Business No. Employees

[ ] Other


[ ] Slab [X] Crawl Space [ ] Basement w/plumbing [ ] Basement wo/plumbing

Water Supply: [X] Individual [ ] Public [ ] Community


Comments:/Conditions:

Comments:/Conditions:

INITIAL SITE SKETCH (1" = 50')

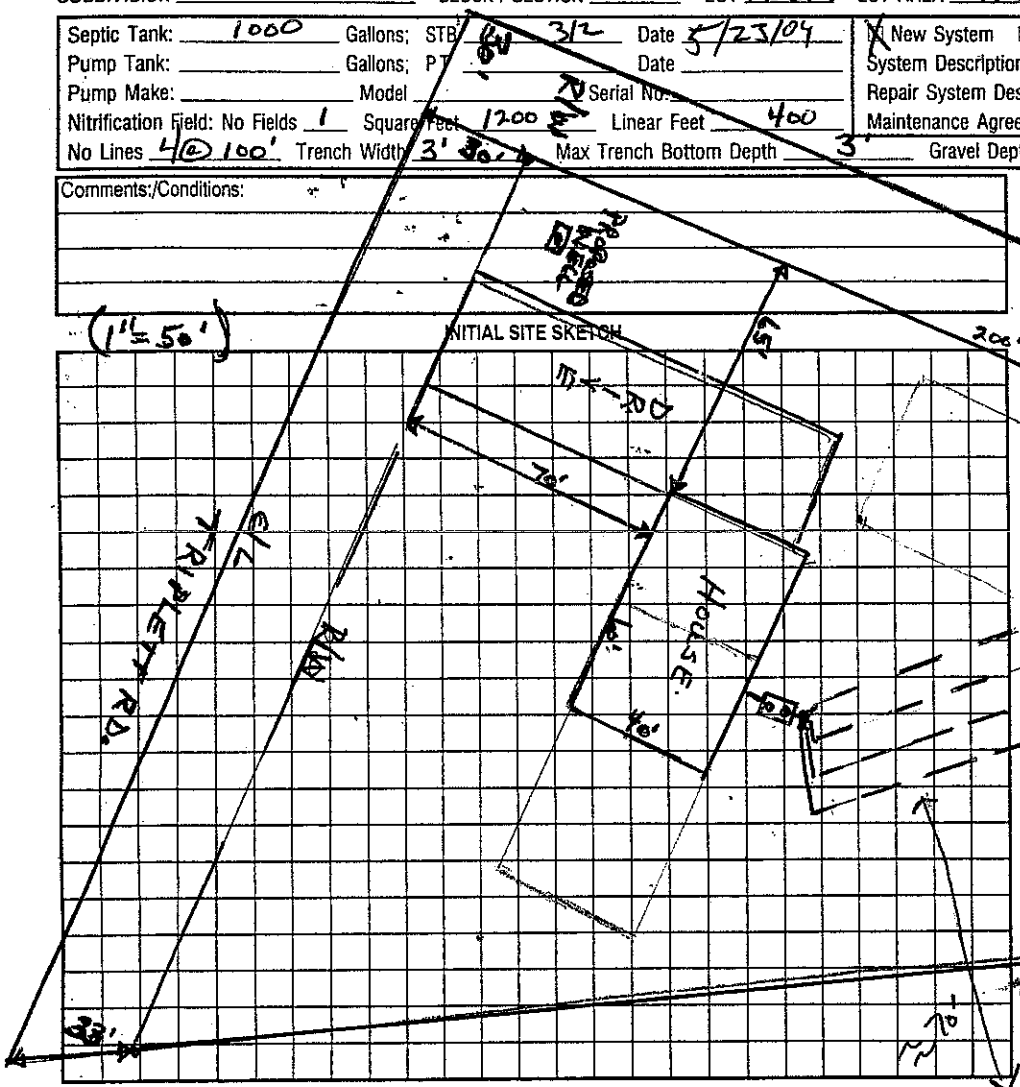

AS BUILT SKETCH

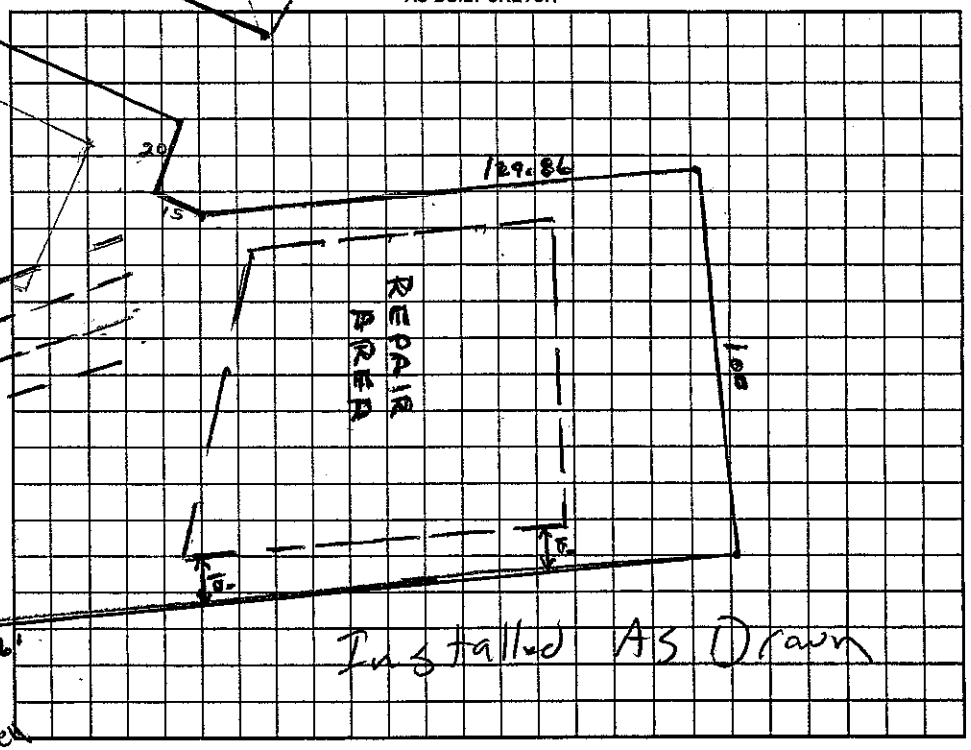

Permit can be suspended or revoked if any false information is supplied toward securing the permit/any unauthorized changes are made to the site/any unauthorized changes are made in the installation of the system. Improvement Permit with plat valid without expiration. Improvement Permit with site plan valid for sixty months. Authorization to Construct is valid for a period equal to that of Improvement Permit – not to exceed sixty months.

Signed: Samuel D. Ferguson date 8-5-03

Improvement Permit by: Wesley Sparks R.S. date 7/31/03

Authorization to Construct by: Wesley Sparks R.S. date 3/1/04

Installed by: Larry Beam

Operation Permit by: Gary Murray R.S. date 6/29/04

Existing System Inspection by: date

HEALTH DEPT. COPY: WHITE OWNER COPY (FINAL): YELLOW OWNER COPY (INITIAL): PINK