# IREDELL COUNTY HEALTH DEPARTMENT

STATESVILLE 704-878-5305 MOORESVILLE 704-664-5281

## IMPROVEMENT PERMIT / AUTHORIZATION TO CONSTRUCT / OPERATION PERMIT / EXISTING SYSTEM INSPECTION

PERMIT# 092662 PIN# 4679 18 5402 DATE 10/25/00

OWNER OR CONTRACTOR Dana Davis PHONE: Business Home 799-9577

ADDRESS 117 Confederate Rd. Mt Ulla, NC. 28125

LOCATION 115 N TR Mazeppa Rd TL Triplett Rd. TR Confederate Rd to 2nd Drive on (L)

SUBDIVISION N/A BLOCK / SECTION LOT LOT AREA ~1.5AC SITE CLASS. RS DESIGN FLOW 360 L.T.A.R. .3

Septic Tank: EXISTING Gallons; STB Date

Pump Tank: Gallons; PT Date

Pump Make: Model Serial No.

Nitrification Field: No Fields 1 Square Feet 540 Linear Feet 180

No Lines 2 Trench Width 36" Max Trench Bottom Depth 36" Gravel Depth 12"

☒ New System ☐ Repair System Type: I, (II), III, IV, V, VI

System Description: CONVENTIONAL

Repair System Description:

Maintenance Agreement Required: ☐ Yes ☒ No

☒ House/Mod. Home No. Bedrooms 3

☐ Mobile Home No. Bathrooms 3

☐ Business No. Employees


☐ Other

☐ Slab ☒ Crawl Space ☐ Basement w/plumbing ☐ Basement wo/plumbing

Water Supply: ☒ Individual ☐ Public ☐ Community


Comments:/Conditions: Adding bedroom and 42' x 66' Mod. Home
Add filter to outlet pipe from Septic Tank, if top of S/T deeper than 6" risers must be added also.

(1" = 50') INITIAL SITE SKETCH

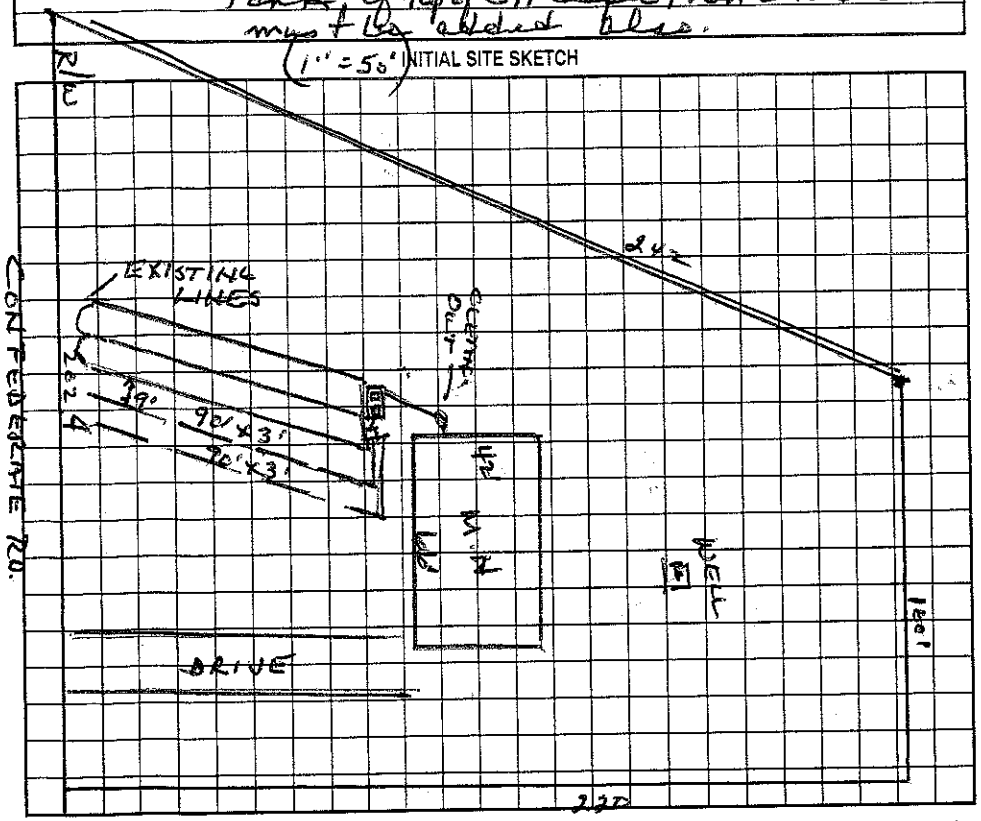


Comments:/Conditions:

NEW / AS-BUILT SKETCH

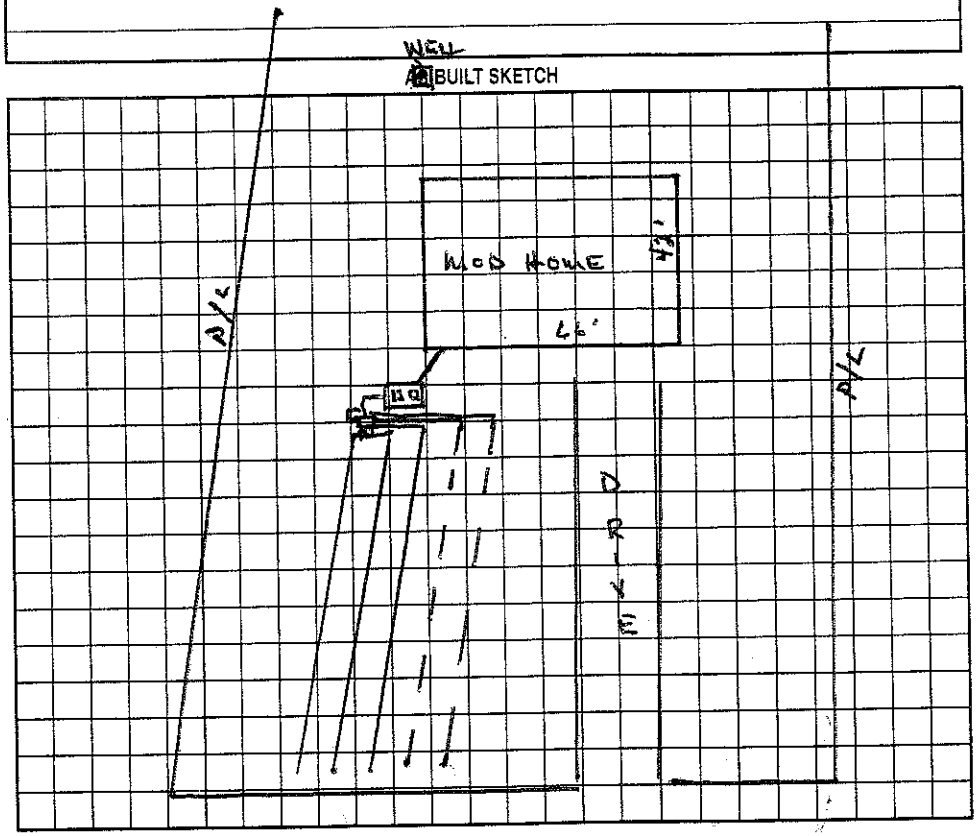


Permit can be suspended or revoked if any false information is supplied toward securing the permit/any unauthorized changes are made to the site/any unauthorized changes are made in the installation of the system. Improvement Permit with plat valid without expiration. Improvement Permit with site plan valid for sixty months. Authorization to Construct is valid for a period equal to that of Improvement Permit – not to exceed sixty months.

Signed: Danielle Davis date 10-26-00

Improvement Permit by: Wesley Sparks RS. date 10/25/00

Authorization to Construct by: Wesley Sparks RS. date 10/25/00

Installed by: Larry Beam

Operation Permit by: Wesley Sparks RS. date 10/26/00

Existing System Inspection by: date

HEALTH DEPT. COPY: WHITE OWNER COPY (FINAL): YELLOW OWNER COPY (INITIAL): PINK