IREDELL COUNTY HEALTH DEPARTMENT

Auth to Construct

STATESVILLE 704-878-5305 MOORESVILLE 704-664-5281

IMPROVEMENT PERMIT / ~~CERTIFICATE OF COMPLETION~~ / OPERATION PERMIT / EXISTING SYSTEM INSPE

PROPERTY DESCRIPTION NO. 067698 DATE 6/25/97 TAX MAP NO. 4679188658 Watershed: ☒ Yes

OWNER OR CONTRACTOR Dana Dee Davis PHONE: Business 704 Home (704) 663-1229

ADDRESS 1897 Triplett Rd Mt. Ulla NC 28125

LOCATION Triplett Rd TL Confederate Rd on left

SUBDIVISION Franklin Davis BLOCK / SECTION ____ LOT 1 LOT AREA 1.59 Acre SITE CLASS. P.S. DESIGN FLOW 240gpd L.T.A.R. .3

Septic Tank: 1000 Gallons; STB 794 Date 4/22/97
Pump Tank: ____ Gallons; PT ____ Date ____
Pump Make: ____ Model ____ Serial No. ____
Nitrification Field: No Fields 1 Square Feet 810' Linear Feet 270
No Lines 3 @ 90' Trench Width 36" Max Trench Bottom Depth 36" Gravel Depth 12"

☒ New System ☐ Repair System Type: I, II, III, IV, V, VI
System Description: Gravity - Conventional
Repair System Description: Same
Maintenance Agreement Required: ☐ Yes ☒ No

☒ House/Mod. Home No. Bedrooms 2
☐ Mobile Home No. Bathrooms ____
☐ Business No. Employees ____
☐ Other ____


☐ Slab ☒ Crawl Space ☐ Basement w/plumbing ☐ Basement wo/plumbing

Water Supply:
☒ Individual
☐ Community
☐ Public

Comments: (A few different areas are okay for "Repair area.

Comments:

INITIAL SITE SKETCH Scale 1:50

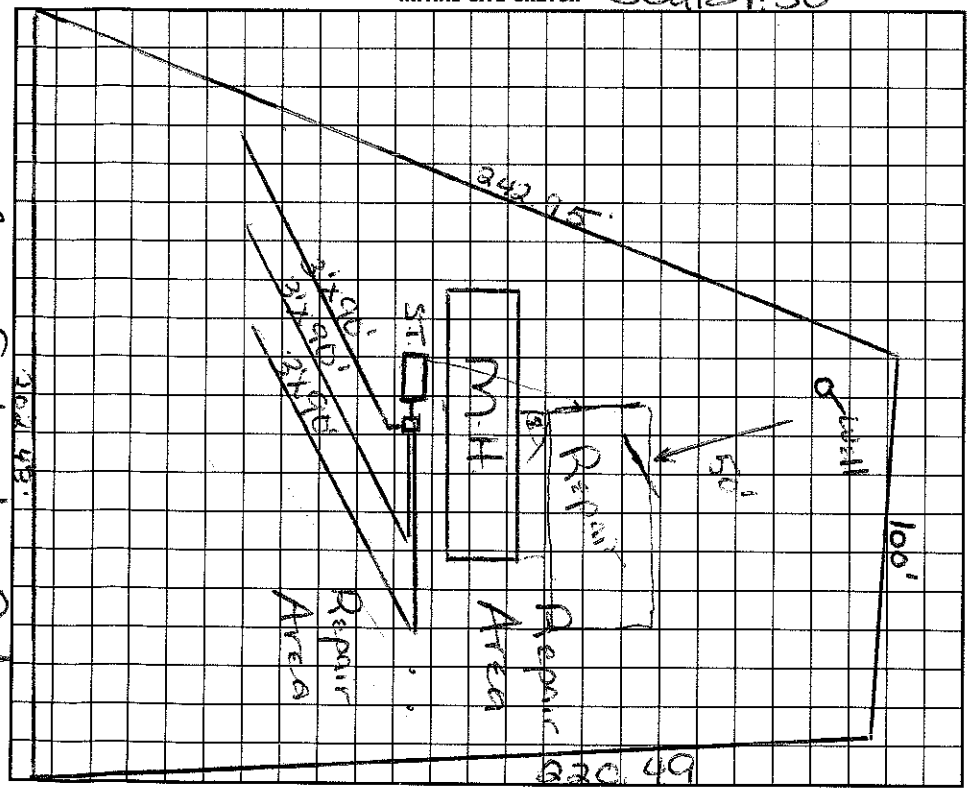

AS BUILT SKETCH

SAME AS SITE SKETCH

I understand that this permit can be suspended or revoked if any false information is supplied toward securing the permit/any unauthorized changes are made to the site/any unauthorized changes are made in the installation of the system. Improvement Permit is valid for 60 months from date of issuance.

Signed: Danielle Welcher

Improvement Permit by: Myra Dotson date 6/25/97

Existing System Inspection by: Myra Dotson date 6/25/97

Installed by: LARRY BEAM

Certificate of Completion by: ____ date ____

Operation Permit by: [signature] date 7/17/97

HEALTH DEPT. COPY: WHITE INSPECTION COPY (FINAL): GREEN OWNER COPY (FINAL): YELLOW INSPECTION COPY (INITIAL): PINK OWNER COPY (INITIAL): GOLD