IREDELL COUNTY HEALTH DEPARTMENT

STATESVILLE 704-878-5305 MOORESVILLE 704-664-5281

IMPROVEMENT PERMIT / CERTIFICATE OF COMPLETION / OPERATION PERMIT / EXISTING SYSTEM INSPECTION

PROPERTY DESCRIPTION NO. 16,794 DATE Nov. 17, 93 TAX MAP NO. 2F-11-A-41 Watershed: ☑ Yes ☐ No

OWNER OR CONTRACTOR Martha Furman PHONE: Business _____ Home _____ L.N.

ADDRESS Academy St. Mooresville

LOCATION I-77 to exit 36 to Poplar Grove Rt on Tawny Back on Right

SUBDIVISION Poplar Grove BLOCK / SECTION _____ LOT 41 LOT AREA ~3/4 AC SITE CLASS PS DESIGN FLOW 360 gpd L.T.A.R. .3 gal/ft²/day

Septic Tank: 1000 Gallons; STB 794-Bellinger Date 4-14-94

Pump Tank: 1000 Gallons; PT 27 Bellinger Date 4-2-94

Pump Make: _____ Model _____ Serial No. _____

Nitrification Field: No Fields 1 Square Feet 1200 Linear Feet 400

No Lines 5 Trench Width 36" Max Trench Bottom Depth 36" Gravel Depth 12"

☑ New System ☐ Repair System Type: I, II, III, IV, V, VI

System Description: pumped conventional

Repair System Description: LP PBPS

Maintenance Agreement Required: ☐ Yes ☑ No

☑ House/Mod. Home No. Bedrooms 3

☐ Mobile Home No. Bathrooms 2

☐ Business No. Employees _____

☐ Other _____


☐ Slab ☑ Crawl Space ☐ Basement w/plumbing ☐ Basement wo/plumbing

Water Supply: ☑ Individual ☐ Community ☐ Public

Comments: Follow contour with laterals. Base 200 gal per 7 minute cycle. Pump Spec: 30 gal/min at Approx. 30' head.

Comments:

INITIAL SITE SKETCH

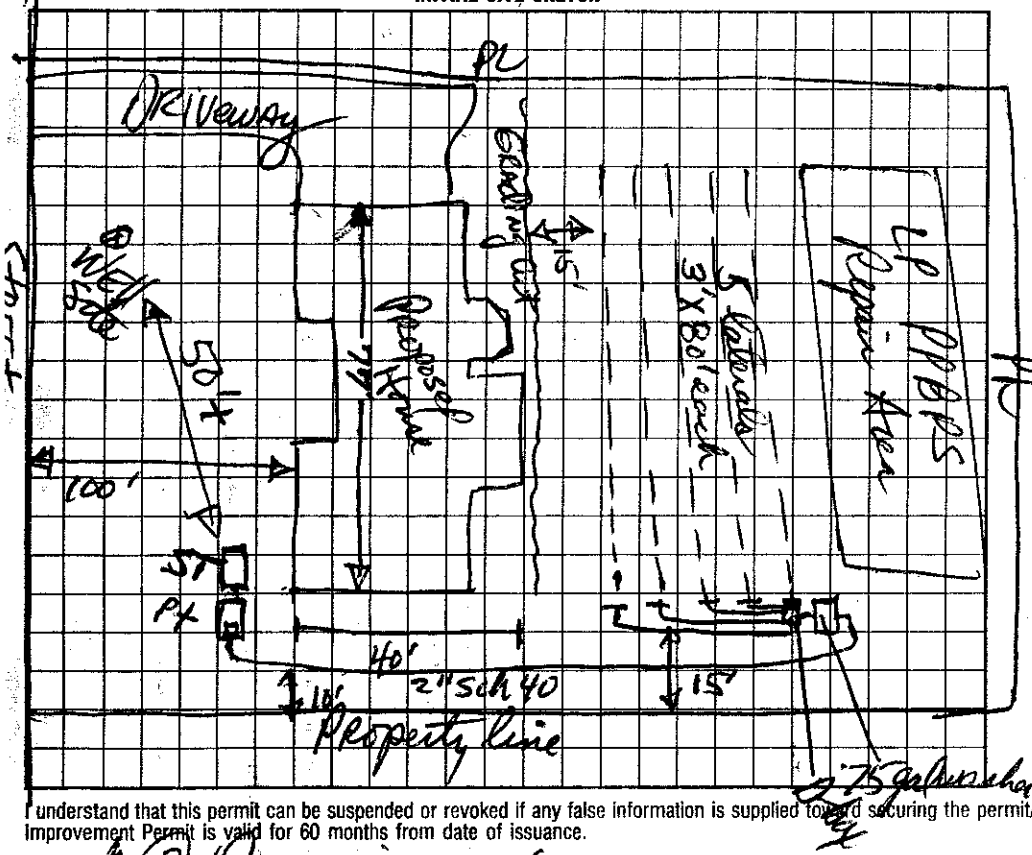

AS BUILT SKETCH

Substantially as shown on Initial sketch

I understand that this permit can be suspended or revoked if any false information is supplied toward securing the permit/any unauthorized changes are made to the site/any unauthorized changes are made in the installation of the system. Improvement Permit is valid for 60 months from date of issuance.

Signed: _____

Improvement Permit by: David R. Henson, RS date 11/15/93

Existing System Inspection by: _____ date _____

Installed by: A G Erwin

Certificate of Completion by: _____ date _____

Operation Permit by: David R. Henson, RS date 8/26/94

HEALTH DEPT. COPY: WHITE INSPECTION COPY (FINAL): GREEN OWNER COPY (FINAL): YELLOW INSPECTION COPY (INITIAL): PINK OWNER COPY (INITIAL): GOLD