2/24/2000 4:00

IREDELL COUNTY HEALTH DEPARTMENT

STATESVILLE 704-878-5305 MOORESVILLE 704-664-5281

IMPROVEMENT PERMIT / AUTHORIZATION TO CONSTRUCT / OPERATION PERMIT / EXISTING SYSTEM INSPECTION

PERMIT# 83550 PIN# 4679 12 7865 PT 4679 21 2849 DATE 9/24/99

OWNER OR CONTRACTOR SPEAR CONSTRUCTION PHONE: Business 361-7518 Home

ADDRESS 607 ANDERSON AVE. SALISBURY 28144

LOCATION 601 N - TL ~~SR 2~~ TRIPLETT. 0 3.20 ON LT

SUBDIVISION KILBOURNE BLOCK / SECTION LOT 3 LOT AREA 1 AC SITE CLASS PS DESIGN FLOW 360 L.T.A.R. .25

Septic Tank: 1000 Gallons; STB 825 Date 12/14/99

Pump Tank: 1000 Gallons; PT 302 Date 12/14/99

Pump Make: ZOELLER Model N-98B Serial No. 11/30/99

Nitrification Field: No Fields 1 Square Feet 1500 Linear Feet 500

No Lines ~~0~~ Trench Width 36" Max Trench Bottom Depth 18-24" Gravel Depth 12"

☑ New System ☐ Repair System Type: I, II, III, IV, V, VI

System Description: PUMP CONVENTIONAL

Repair System Description: PUMP EZ LAY

Maintenance Agreement Required: ☐ Yes ☑ No

☑ House/Mod. Home No. Bedrooms 3

☐ Mobile Home No. Bathrooms 2

☐ Business No. Employees

☐ Other

☐ Slab ☑ Crawl Space ☐ Basement w/plumbing ☐ Basement wo/plumbing


Water Supply: ☑ Individual ☐ Public ☐ Community

Comments:/Conditions: @ 125'

Comments:/Conditions:

1" = 50'

INITIAL SITE SKETCH

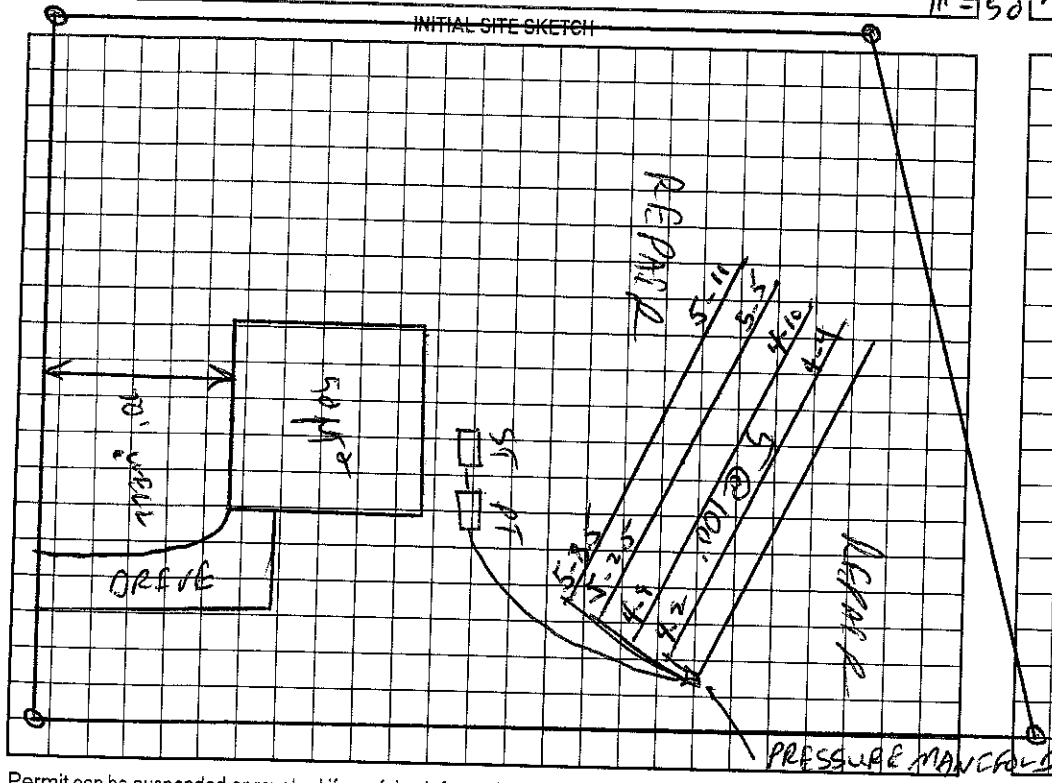

AS BUILT SKETCH

Permit can be suspended or revoked if any false information is supplied toward securing the permit/any unauthorized changes are made to the site/any unauthorized changes are made in the installation of the system. Improvement Permit with plat valid without expiration. Improvement Permit with site plan valid for sixty months. Authorization to Construct is valid for a period equal to that of Improvement Permit – not to exceed sixty months.

Signed: _____ date 9-24-99 Installed by: Rowan Septic

Improvement Permit by: C. B. Thom date 9/24/99 Operation Permit by: C. B. Thom RS date 3/3/00

Authorization to Construct by: C. B. Thom date 9/24/99 Existing System Inspection by: _____ date _____

HEALTH DEPT. COPY: WHITE OWNER COPY (FINAL): YELLOW OWNER COPY (INITIAL): PINK