IREDELL COUNTY HEALTH DEPARTMENT

STATESVILLE 704-878-5305 MOORESVILLE 704-664-5281

IMPROVEMENT PERMIT / AUTHORIZATION TO CONSTRUCT / OPERATION PERMIT / EXISTING SYSTEM INSPECTION

PERMIT# 83549 PIN# 4679127865 PT 4679213767 DATE 9/21/99

OWNER OR CONTRACTOR SPEAR CONSTRUCTION PHONE: Business 361-7518 Home

ADDRESS 607 ANDERSON AVE -

LOCATION 501 N-TL TRIPLETT RD- 2nd DN RT

SUBDIVISION KILBORNE BLOCK / SECTION - LOT 5 LOT AREA 1.0 AC SITE CLASS. PS DESIGN FLOW 360 L.T.A.R. .3

Septic Tank: 1000 Gallons; STB 825 Date 11/1/99
Pump Tank: 1000 Gallons; PT 302 Date 12/10/99
Pump Make: ZOELLER Model N-98C Serial No.
Nitrification Field: No Fields 1 Square Feet 1200 Linear Feet 400
No Lines 3@133' Trench Width 36" Max Trench Bottom Depth 36" Gravel Depth 12"

☑ New System ☐ Repair System Type: I, II, (III), IV, V, VI
System Description: PUMP CONVENTIONAL
Repair System Description: PUMP PANEL
Maintenance Agreement Required: ☐ Yes ☑ No

☑ House/Mod. Home No. Bedrooms 3
☐ Mobile Home No. Bathrooms 2
☐ Business No. Employees
☐ Other


☐ Slab ☑ Crawl Space ☐ Basement w/plumbing ☐ Basement wo/plumbing

Water Supply: ☑ Individual ☐ Public ☐ Community


Comments:/Conditions:

Comments:/Conditions:

INITIAL SITE SKETCH

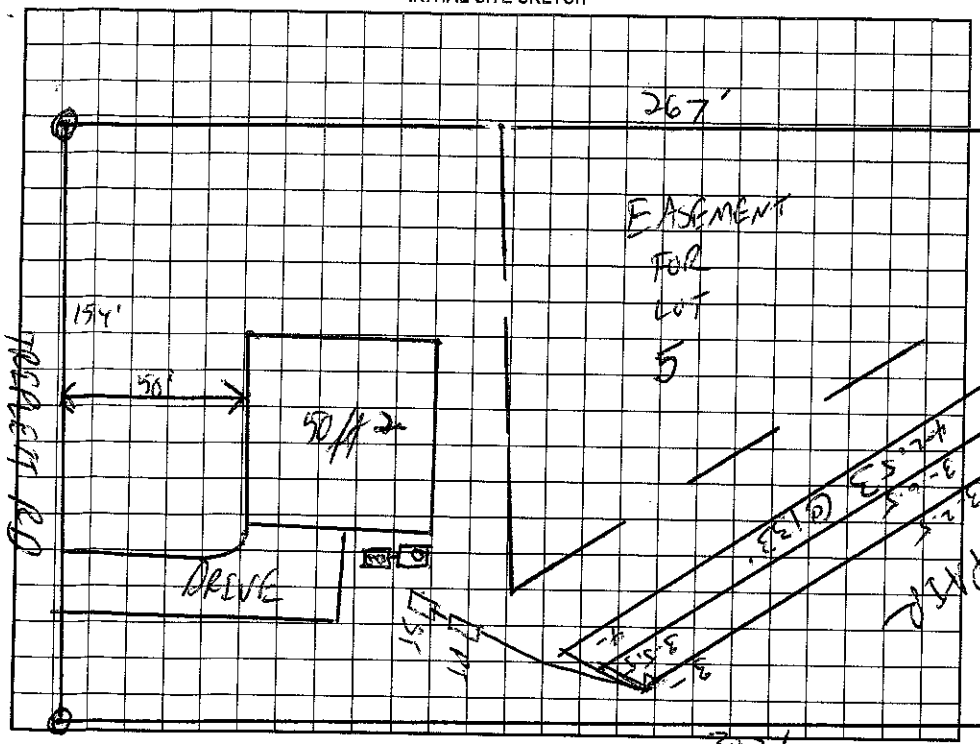

AS BUILT SKETCH

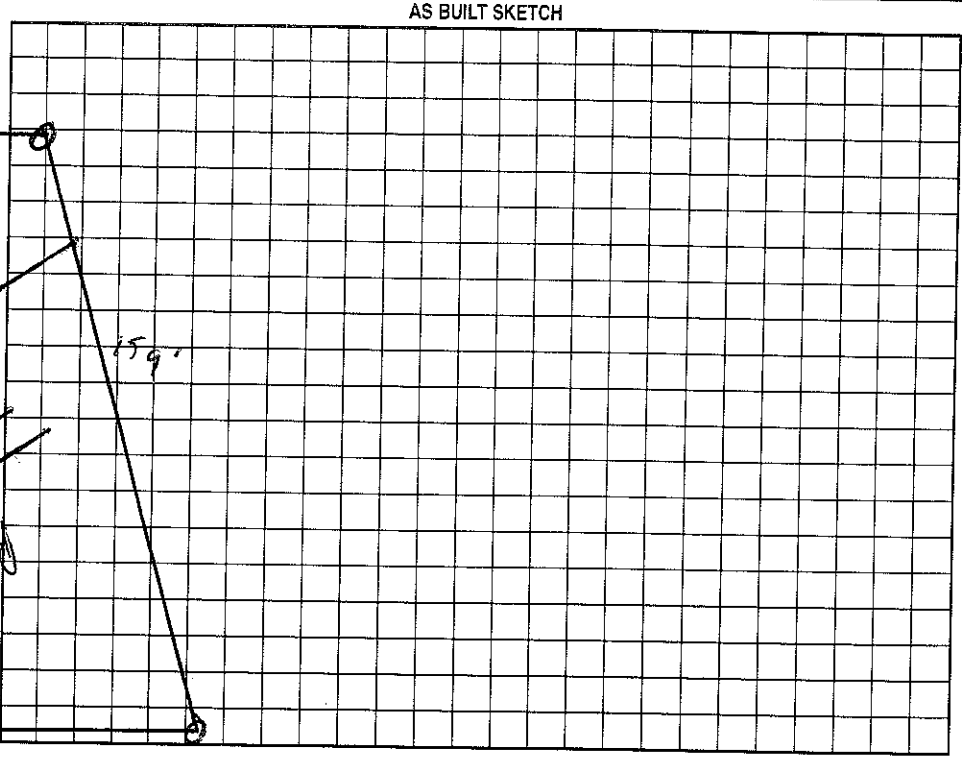

Permit can be suspended or revoked if any false information is supplied toward securing the permit/any unauthorized changes are made to the site/any unauthorized changes are made in the installation of the system. Improvement Permit with plat valid without expiration. Improvement Permit with site plan valid for sixty months. Authorization to Construct is valid for a period equal to that of Improvement Permit – not to exceed sixty months.

Signed: date 9-22-99 Installed by: Rowan Septic Tank

Improvement Permit by: C. Bailey Freeman RS date 9/21/99 Operation Permit by: Manuel H. Ellison RS date 3/23/2000

Authorization to Construct by: C. Bailey Freeman RS date 9/21/99 Existing System Inspection by: date

HEALTH DEPT. COPY: WHITE OWNER COPY (FINAL): YELLOW OWNER COPY (INITIAL): PINK