IREDELL COUNTY HEALTH DEPARTMENT

STATESVILLE 704-878-5305 MOORESVILLE 704-664-3281

IMPROVEMENT PERMIT / AUTHORIZATION TO CONSTRUCT / OPERATION PERMIT / EXISTING SYSTEM INSPECTION

PERMIT# 83548 PIN# ~~4679 12 7865 PF~~ 4679 21 4643 DATE 9/21/99

OWNER OR CONTRACTOR SPEAR CONSTRUCTION PHONE: Business _____ Home 361-7518

ADDRESS 607 ANDERSON AVE SALISBURY NC 28144

LOCATION 801 N-TL TRIPLETT - 1ST ON RT

SUBDIVISION KILBOURNE Farms BLOCK / SECTION _____ LOT 1 LOT AREA 1.0AC SITE CLASS. PS DESIGN FLOW 360 L.T.A.R. .3

Septic Tank: 1000 Gallons; STB $25 Date 9/4/99
Pump Tank: _____ Gallons; PT _____ Date _____
Pump Make: _____ Model _____ Serial No. _____
Nitrification Field: No. Fields 1 Square Feet 900 Linear Feet 300
No. Lines ~~3~~ 6 ~~100'~~ Trench Width 36" Max Trench Bottom Depth 24"

☑ New System ☐ Repair System Type: I, II, III, IV, V, VI
System Description: GRAVITY 25% REDUCTION
Repair System Description: GRAVITY SAME
Maintenance Agreement Required: ☐ Yes ☑ No
Gravel Depth N/A


☑ House/Mod. Home No. Bedrooms 3
☐ Mobile Home No. Bathrooms 2
☐ Business No. Employees ____
☐ Other _____
☐ Slab ☑ Crawl Space ☐ Basement w/plumbing ☐ Basement wo/plumbing

Water Supply: ☑ Individual ☐ Public ☐ Community


Comments:/Conditions:

Comments:/Conditions:

INITIAL SITE SKETCH 1"=50'

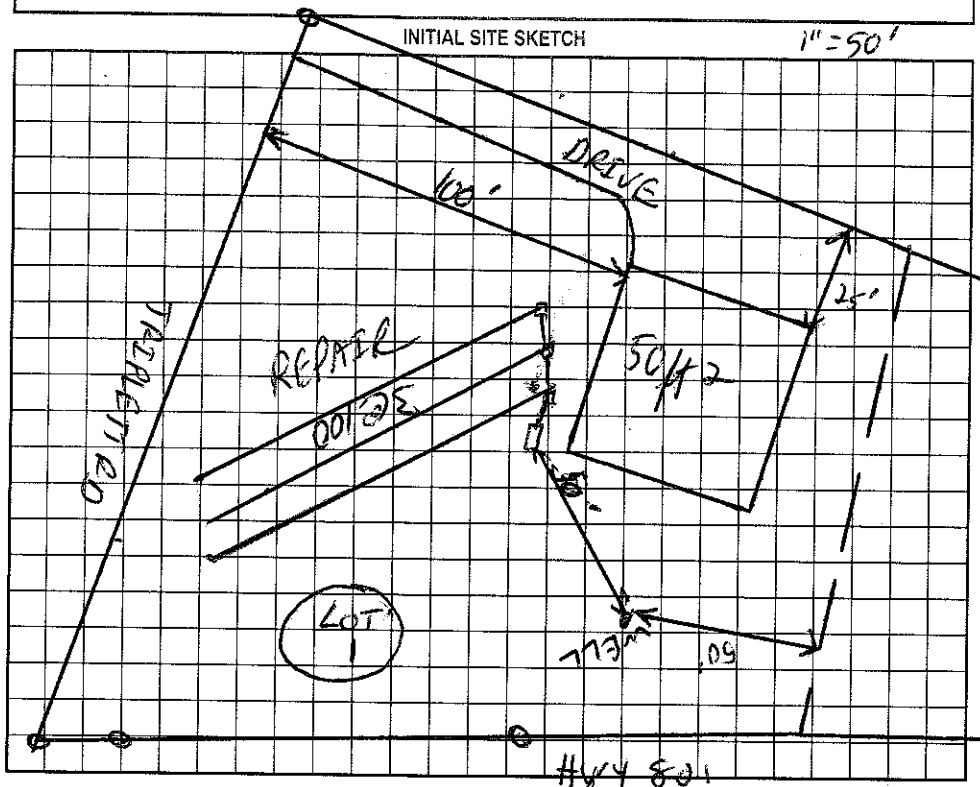

AS BUILT SKETCH

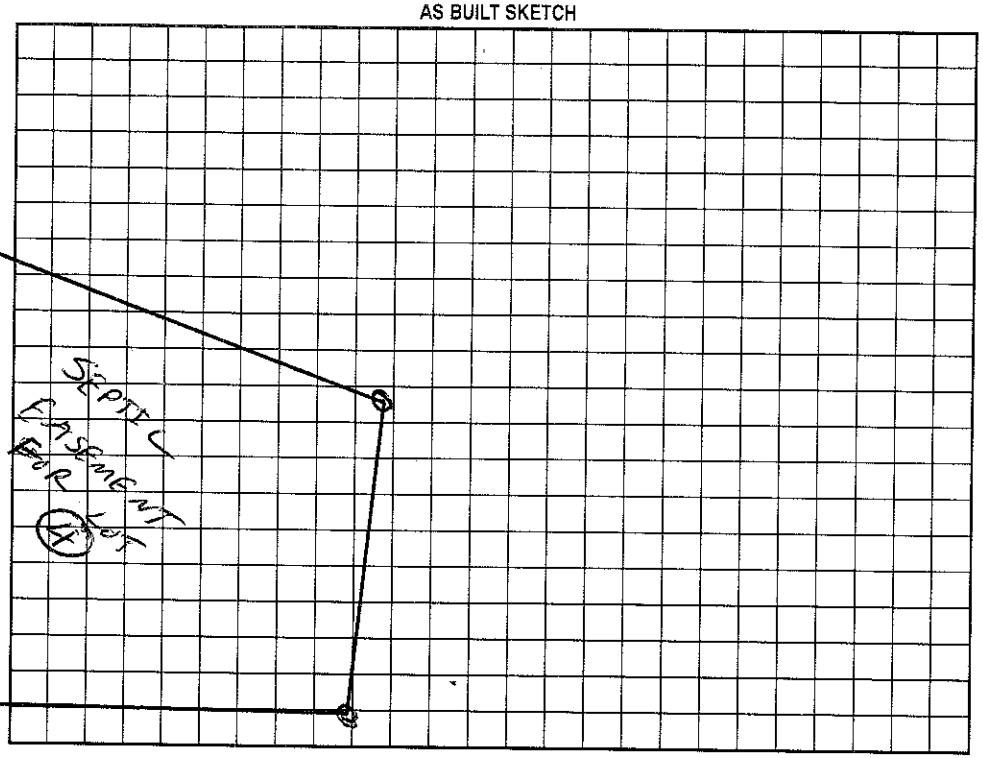

Permit can be suspended or revoked if any false information is supplied toward securing the permit/any unauthorized changes are made to the site/any unauthorized changes are made in the installation of the system. Improvement Permit with plat valid without expiration. Improvement Permit with site plan valid for sixty months. Authorization to Construct is valid for a period equal to that of Improvement Permit – not to exceed sixty months.

Signed: _____ date 9-24-99 Installed by: Rowan Septic Tank

Improvement Permit by: _____ date 9/21/99 Operation Permit by: _____ date 11/30/99

Authorization to Construct by: _____ date 9/21/99 Existing System Inspection by: _____ date _____

HEALTH DEPT. COPY: WHITE OWNER COPY (FINAL): YELLOW OWNER COPY (INITIAL): PINK