IREDELL COUNTY HEALTH DEPARTMENT

STATESVILLE 704-878-5305 MOORESVILLE 704-664-5281

IMPROVEMENT PERMIT / AUTHORIZATION TO CONSTRUCT / OPERATION PERMIT / EXISTING SYSTEM INSPECTION

PERMIT# 124007 PIN# ~~4679-22-2317.000~~ / 4679215992.000 DATE 12/28/04

OWNER OR CONTRACTOR Paul Allyn / Medallion Prop. PHONE: Business 7046636905 Home

ADDRESS 318 Glenwood Dr. Mooresville NC 28115

LOCATION Hwy 801, TL Dupree Ln., on corner

SUBDIVISION Dupree Est BLOCK / SECTION LOT 1 LOT AREA 1.00 AC SITE CLASS PS DESIGN FLOW 480 L.T.A.R. 0.3

Septic Tank: 1000 Gallons; STB 825 Date 5/01/06
Pump Tank: 1000 Gallons; PT 502 Date 5/02/06
Pump Make: Zoeller Model N152 Serial No.
Nitrification Field: No Fields 1 Square Feet 810 Linear Feet 270'
No Lines 6@45' Trench Width 24" 8 Foc Max Trench Bottom Depth 36" Gravel Depth —

☒ New System ☐ Repair System Type: I, II, III, IV, V, VI
System Description: PM - Panel Block
Repair System Description: LP Panel Block
Maintenance Agreement Required: ☐ Yes ☒ No

☒ House/Mod. Home No. Bedrooms 4
☐ Mobile Home No. Bathrooms
☐ Business No. Employees
☐ Other


☐ Slab ☒ Crawl Space ☐ Basement w/plumbing ☐ Basement wo/plumbing

Water Supply: ☒ Individual ☐ Public ☐ Community


Comments/Conditions:
1"=50'
OR 36" 9 Foc
House will be 85' From Back 35' From Side
⊗ Well

Comments/Conditions:

INITIAL SITE SKETCH

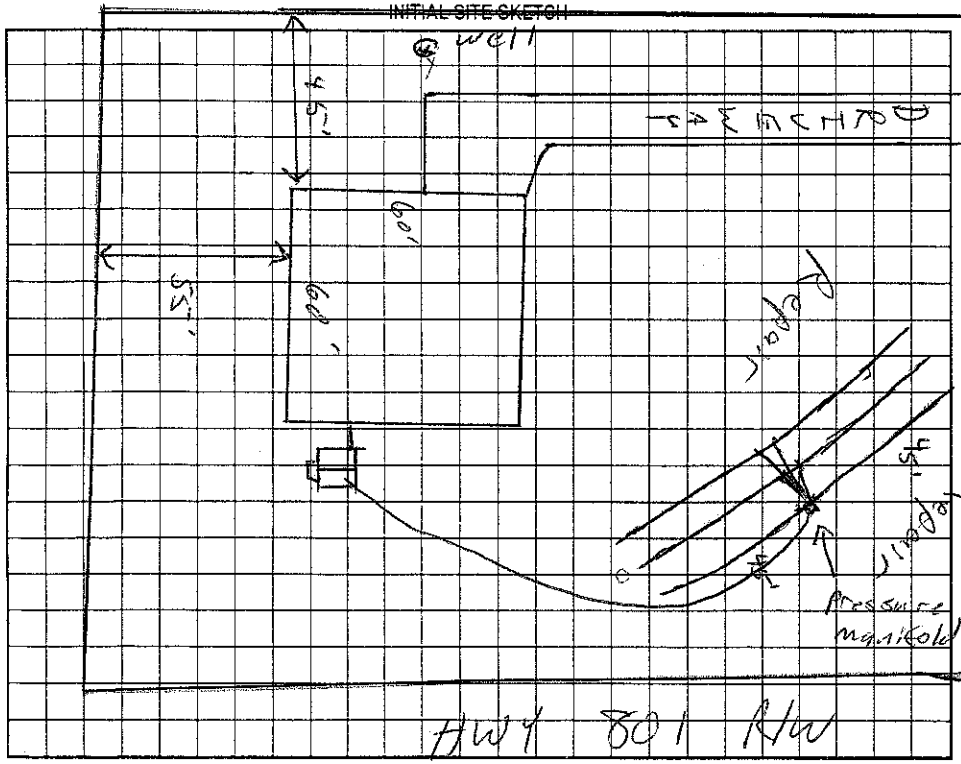

AS BUILT SKETCH

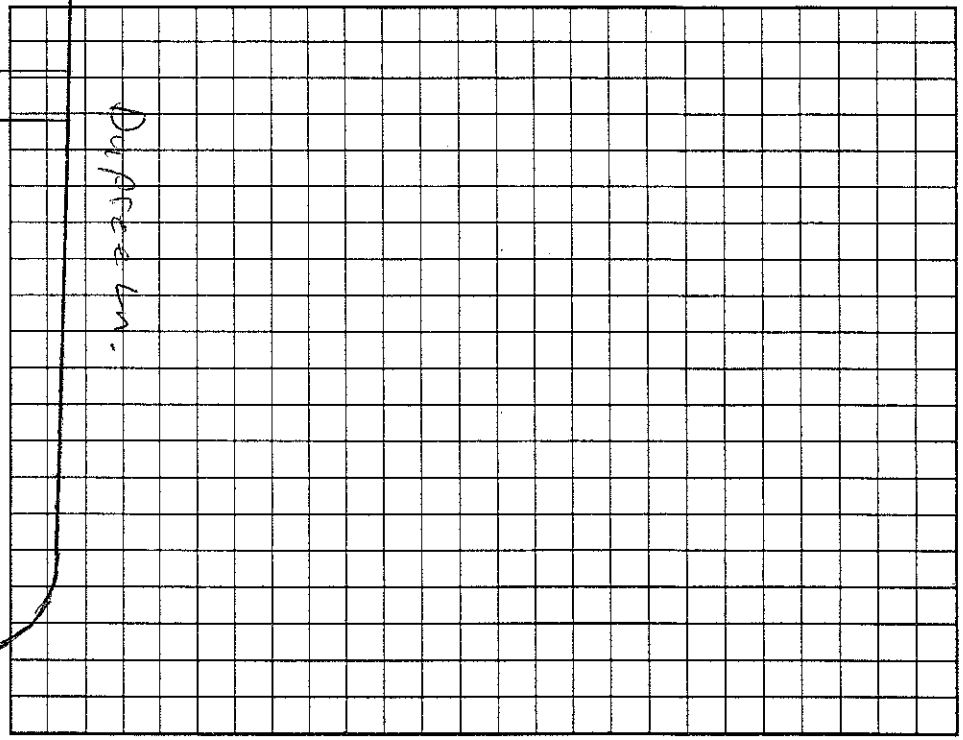

Permit can be suspended or revoked if any false information is supplied toward securing the permit/any unauthorized changes are made to the site/any unauthorized changes are made in the installation of the system. Improvement Permit with plat valid without expiration. Improvement Permit with site plan valid for sixty months. Authorization to Construct is valid for a period equal to that of Improvement Permit – not to exceed sixty months.

Signed: Melanie L. Keller date 2/4/05 Installed by: Rowan Septic

Improvement Permit by: RS date 12/28/04 Operation Permit by: RS date 7/20/06

Authorization to Construct by: RS date 2/2/06 Existing System Inspection by: date

HEALTH DEPT. COPY: WHITE OWNER COPY (FINAL): YELLOW OWNER COPY (INITIAL): PINK