IREDELL COUNTY HEALTH DEPARTMENT

STATESVILLE 704-878-5305 MOORESVILLE 704-664-5281

IMPROVEMENT PERMIT / AUTHORIZATION TO CONSTRUCT / OPERATION PERMIT / EXISTING SYSTEM INSPECTION

PERMIT# 83551 PIN# 4679 12 7865 PT 4679221022 DATE 9/24/99

OWNER OR CONTRACTOR SPEAR CONSTRUCTION PHONE: Business 361-7518 Home

ADDRESS 607 ANDERSON AVE

LOCATION SOUTH TO TREPLETT RD- 4TH ON RT

SUBDIVISION KELBOURNE BLOCK / SECTION LOT 4 LOT AREA 1 AC SITE CLASS. PS DESIGN FLOW 360 L.T.A.R. .3

Septic Tank: 1000 Gallons; STB 825 Date 4/2/99

Pump Tank: 1000 Gallons; PT 302 Date 11/3/99

Pump Make: ZOELLER Model N-137C Serial No.

Nitrification Field: No Fields 1 Square Feet 900 Linear Feet 300

No Lines 3 @100' Trench Width 36" Max Trench Bottom Depth 36" Gravel Depth N/A

☑ New System ☐ Repair System Type: I, II, III, IV, V, VI

System Description: PUMP OFFSITE 25%

Repair System Description: SAME

Maintenance Agreement Required: ☐ Yes ☑ No

☑ House/Mod. Home ☐ Mobile Home ☐ Business ☐ Other

No. Bedrooms 3 No. Bathrooms 2 No. Employees


☐ Slab ☑ Crawl Space ☐ Basement w/plumbing ☐ Basement wo/plumbing

Water Supply: ☑ Individual ☐ Public ☐ Community

Comments:/Conditions:

SYSTEM AND REPAIR OFF SITE


INITIAL SITE SKETCH

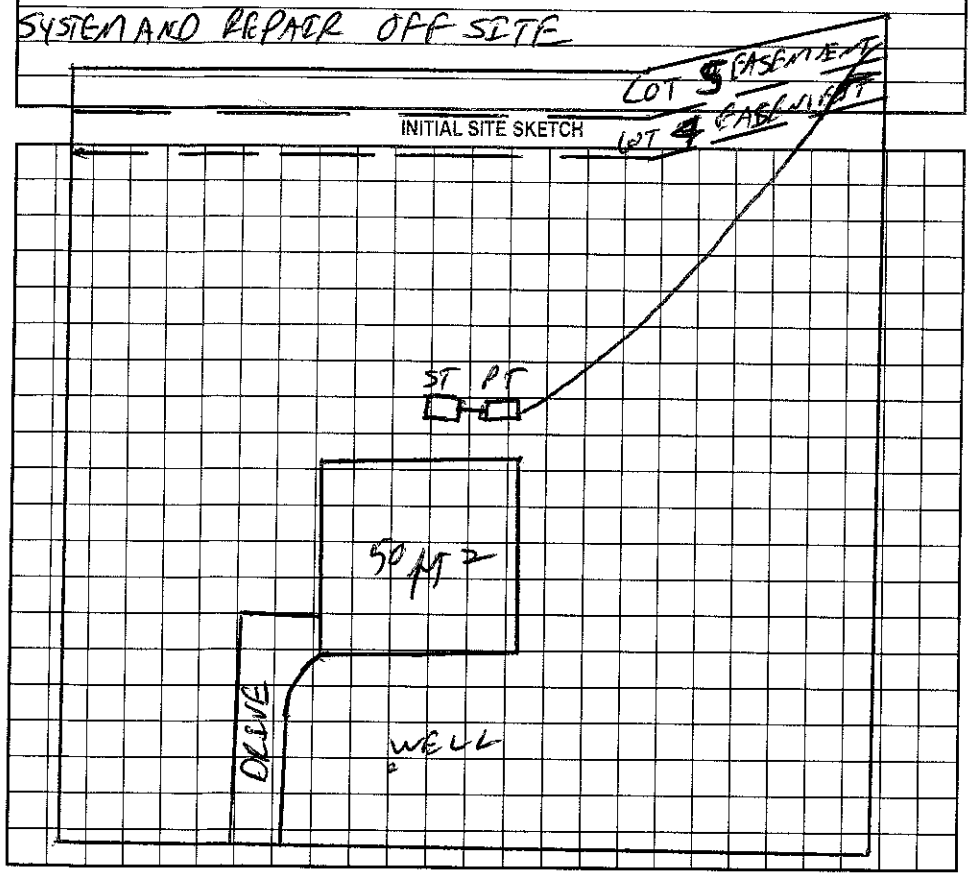

Comments:/Conditions: 4 @ 75' x 3' installed

1" = 50'

AS BUILT SKETCH

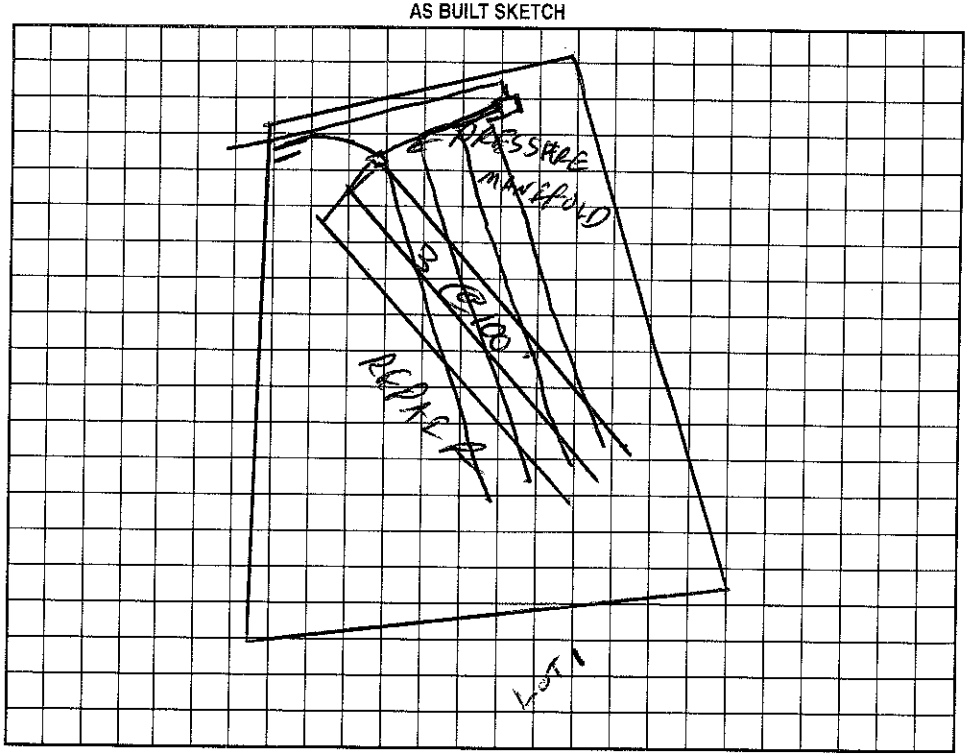

Permit can be suspended or revoked if any false information is supplied toward securing the permit/any unauthorized changes are made to the site/any unauthorized changes are made in the installation of the system. Improvement Permit with plat valid without expiration. Improvement Permit with site plan valid for sixty months. Authorization to Construct is valid for a period equal to that of Improvement Permit – not to exceed sixty months.

Signed: _____ date 9-24-99 Installed by: ZOELLER

Improvement Permit by: C. Thomas date 9/24/99 Operation Permit by: Wesley Sparks R.S. date 1/7/00

Authorization to Construct by: C. Thomas date 9/24/99 Existing System Inspection by: _____ date _____

HEALTH DEPT. COPY: WHITE OWNER COPY (FINAL): YELLOW OWNER COPY (INITIAL): PINK