IREDELL COUNTY HEALTH DEPARTMENT

STATESVILLE 704-878-5305 MOORESVILLE 704-664-5281

IMPROVEMENT PERMIT / AUTHORIZATION TO CONSTRUCT / OPERATION PERMIT / EXISTING SYSTEM INSPECTION

PERMIT# 124 030 PIN# ~~4679-22-2317.005~~ 4679-22-1461 DATE 10/28/04

OWNER OR CONTRACTOR ~~Paul Allen~~ LEB PHONE: Business 704 663-6905 Home

ADDRESS 318 Glenwood Dr. Mooresville NC 28115

LOCATION Hwy 801 N, past Tripplett Rd, TL Dupree Ln, 5th on Lt

SUBDIVISION Dupree Est. BLOCK / SECTION LOT 5 LOT AREA 1.00 Ac SITE CLASS PS DESIGN FLOW 480 L.T.A.R. 0.25

Septic Tank: 1000 Gallons; STB 794 Date 9/21/05
Pump Tank: Gallons; PT Date
Pump Make: Model Serial No.
Nitrification Field: No Fields 1 Square Feet 1440 Linear Feet 480
No Lines 6@80' Trench Width 36" Trench Bottom Depth 36" Minimum Gravel Depth —

☒ New System ☐ Repair System Type: I, II, (III), IV, V, VI
System Description: Gravity 25% Reduction
Repair System Description: Pump 25% Reduction
Maintenance Agreement Required: ☐ Yes ☒ No


☒ House/Mod. Home No. Bedrooms ~~4~~ 3
☐ Mobile Home No. Bathrooms
☐ Business No. Employees
☐ Other
☐ Slab ☒ Crawl Space ☐ Basement w/plumbing ☐ Basement wo/plumbing

Water Supply: ☒ Individual ☐ Public ☐ Community


Comments:/Conditions:
1"=50'

Comments:/Conditions:

INITIAL SITE SKETCH

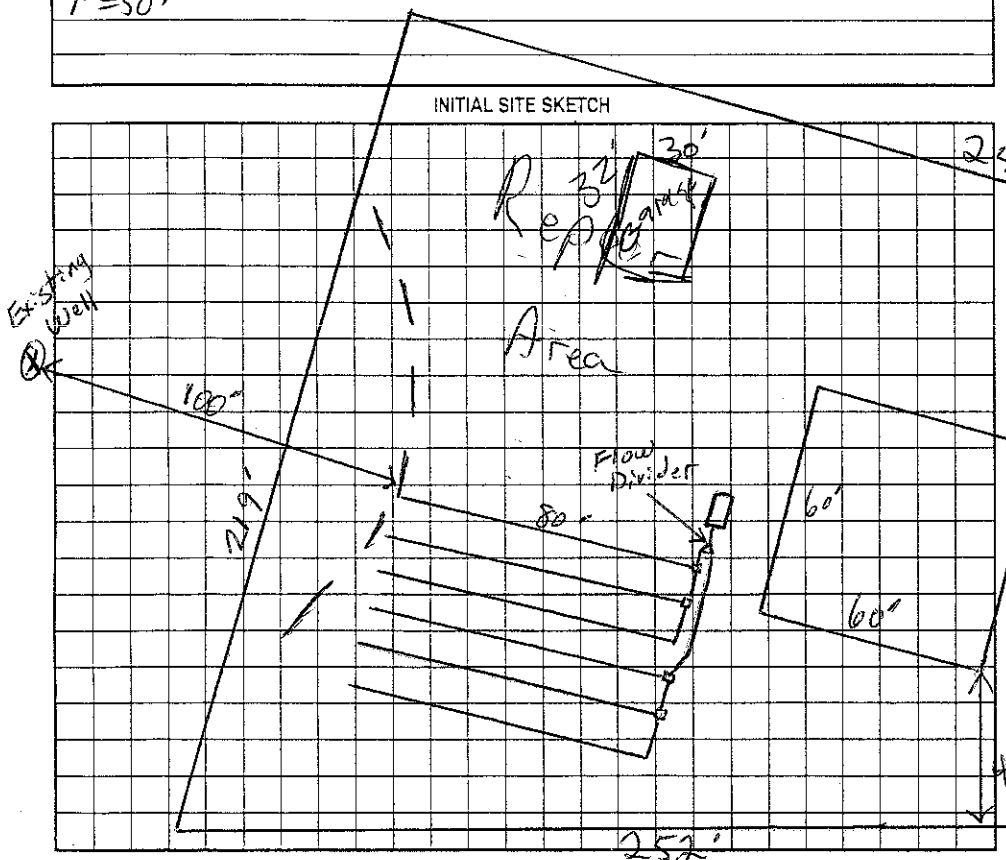

AS BUILT SKETCH

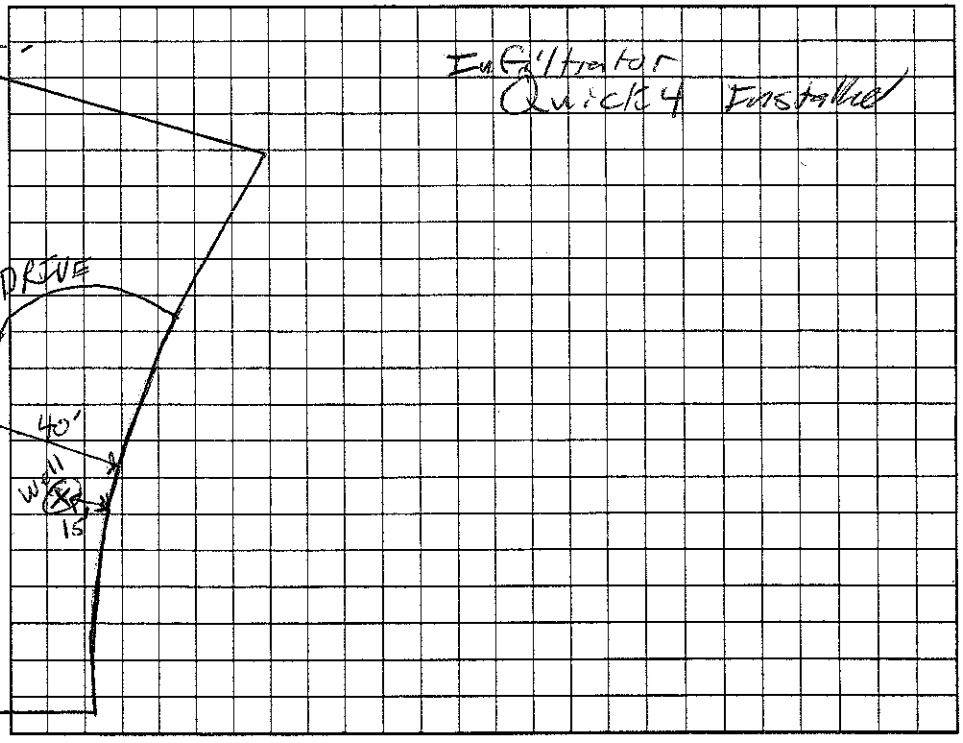

Permit can be suspended or revoked if any false information is supplied toward securing the permit/any unauthorized changes are made to the site/any unauthorized changes are made in the installation of the system. Improvement Permit with plat valid without expiration. Improvement Permit with site plan valid for sixty months. Authorization to Construct is valid for a period equal to that of Improvement Permit – not to exceed sixty months.

Signed: Melanie Allen date 2/14/05 Installed by: Larry Beam

Improvement Permit by: RS date 10/28/04 Operation Permit by: RS date 12/2/05

Authorization to Construct by: Wesley Sparks RS date 6/29/05 Existing System Inspection by: date

HEALTH DEPT. COPY: WHITE OWNER COPY (FINAL): YELLOW OWNER COPY (INITIAL): PINK