4400

IREDELL COUNTY HEALTH DEPARTMENT

STATESVILLE 704-878-5305 MOORESVILLE 704-664-5281

IMPROVEMENT PERMIT / AUTHORIZATION TO CONSTRUCT / OPERATION PERMIT / EXISTING SYSTEM INSPECTION

PERMIT# 124033 PIN# ~~4679-22-2312.000~~ 4679222994.000 DATE 12/30/04

OWNER OR CONTRACTOR Paul Allen PHONE: Business 704 663 6905 Home

ADDRESS 318 Glenwood Dr. Mooresville NC 28115

LOCATION Hwy 801, TL Dupree Ln., at end

SUBDIVISION Dupree Est BLOCK / SECTION LOT 8 LOT AREA 1.22 Ac SITE CLASS. PS DESIGN FLOW 480 L.T.A.R. 0.25

Septic Tank: 1000 Gallons; STB 1007 Date 3-10-06
Pump Tank: 1000 Gallons; PT 274 Date 2-20-06
Pump Make: Model Serial No.
Nitrification Field: No Fields 1 Square Feet 1440 Linear Feet 480
No Lines 4@120' Trench Width 36" Max Trench Bottom Depth 36" Gravel Depth —

☒ New System ☐ Repair System Type: I, II, III, IV, V, VI
System Description: PM 25% Reduction
Repair System Description: same
Maintenance Agreement Required: ☐ Yes ☒ No

☒ House/Mod. Home No. Bedrooms 4
☐ Mobile Home No. Bathrooms
☐ Business No. Employees
☐ Other

☐ Slab ☒ Crawl Space ☐ Basement w/plumbing ☐ Basement wo/plumbing


Water Supply: ☒ Individual ☐ Public ☐ Community

Comments:/Conditions:


1"=50'

Comments:/Conditions: Installed Quick 4

INITIAL SITE SKETCH

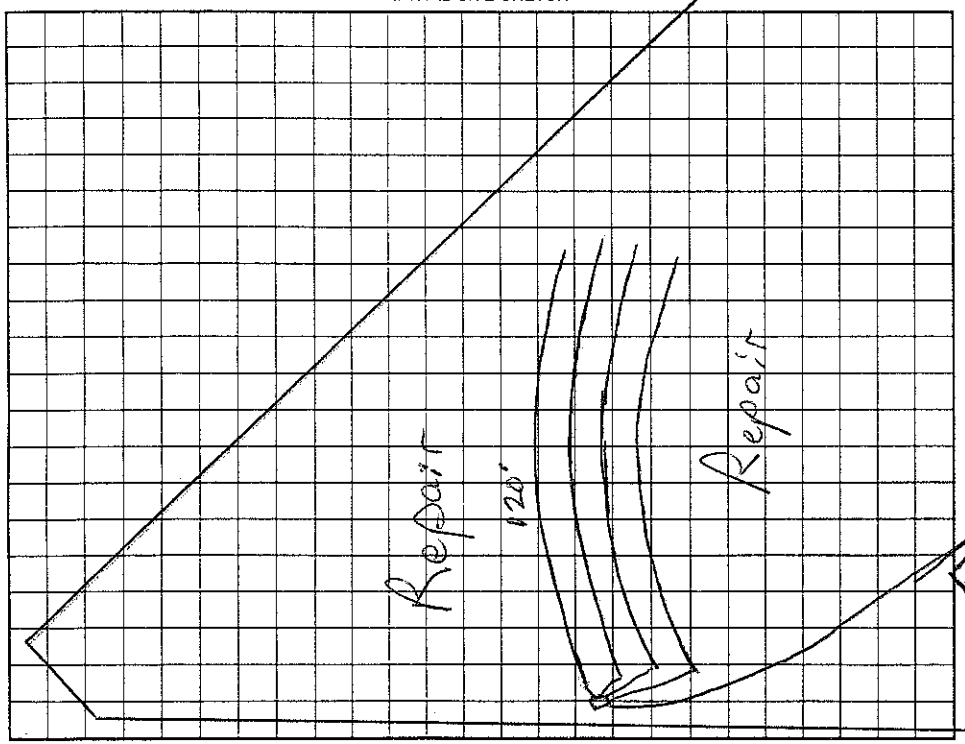

AS BUILT SKETCH

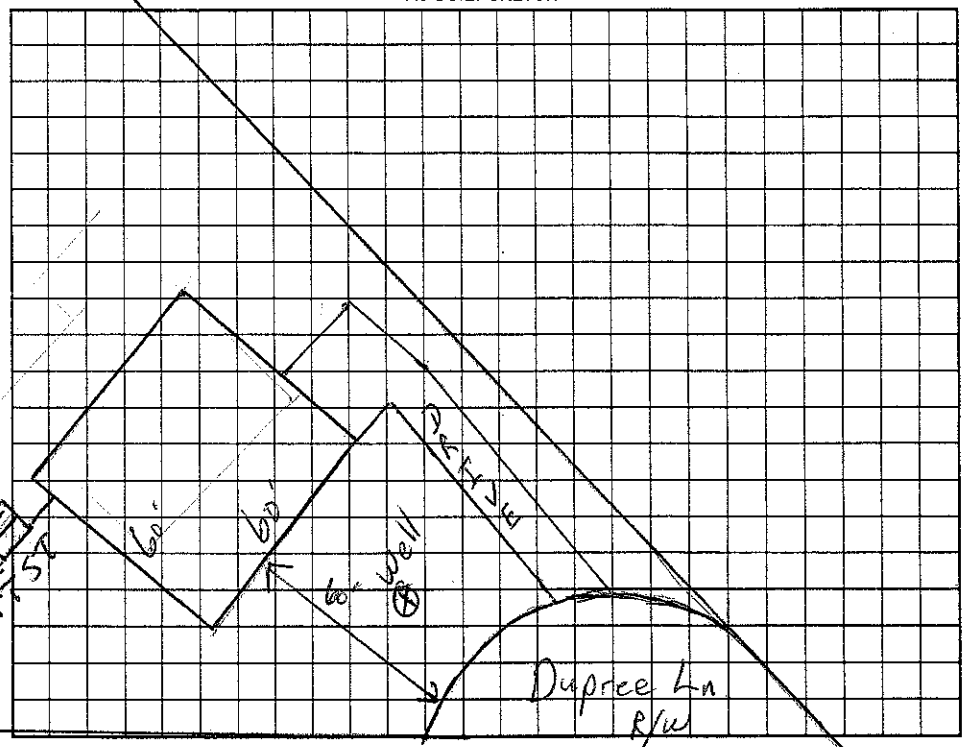

Permit can be suspended or revoked if any false information is supplied toward securing the permit/any unauthorized changes are made to the site/any unauthorized changes are made in the installation of the system. Improvement Permit with plat valid without expiration. Improvement Permit with site plan valid for sixty months. Authorization to Construct is valid for a period equal to that of Improvement Permit – not to exceed sixty months.

Signed: Melanie Allen date 2/4/05 Installed by: Richard Abernathy

Improvement Permit by: RS date 12/30/04 Operation Permit by: date 11/9/06

Authorization to Construct by: RS date 4/9/05 Existing System Inspection by: date

HEALTH DEPT. COPY: WHITE OWNER COPY (FINAL): YELLOW OWNER COPY (INITIAL): PINK