IREDELL COUNTY HEALTH DEPARTMENT

STATESVILLE 873-5305 MOORESVILLE 704-664-5281

IMPROVEMENT PERMIT / AUTHORIZATION TO CONSTRUCT / OPERATION PERMIT / EXISTING SYSTEM INSPECTION

PERMIT# 124028 PIN# ~~4679-22-2317.000~~ 4679-22-3133 DATE 10/29/04

OWNER OR CONTRACTOR Paul Allen / LER Blocks PHONE: Business 704-663-6905 Home

ADDRESS 318 Glenwood Dr Mooresville NC 28115

LOCATION HWY 801, past Tripplett TL Dupree Ln, 3rd on Lt

SUBDIVISION Dupree Est. BLOCK / SECTION LOT 3 LOT AREA 1.00 AC SITE CLASS PS DESIGN FLOW ~~440~~ 360 L.T.A.R. 0.3

Septic Tank: 1000 Gallons; STB 794 Date 2/3/06

Pump Tank: Gallons; PT Date

Pump Make: Model Serial No.

Nitrification Field: No Fields 1 Square Feet ~~1000~~ 900 Linear Feet ~~500~~ 300

No Lines 4 Trench Width 36" Max Trench Bottom Depth 36" Gravel Depth —

☒ New System ☐ Repair System Type: I, II, III, IV, V, VI

System Description: Gravity 25% reduct

Repair System Description: same

Maintenance Agreement Required: ☐ Yes ☐ No

☒ House/Mod. Home No. Bedrooms ~~3~~ 4

☐ Mobile Home No. Bathrooms

☐ Business No. Employees

☐ Other

Water Supply: ☒ Individual ☐ Public ☐ Community


☐ Slab ☒ Crawl Space ☐ Basement w/plumbing ☐ Basement wo/plumbing

Comments:/Conditions:


1"=50'

Comments:/Conditions:

INITIAL SITE SKETCH

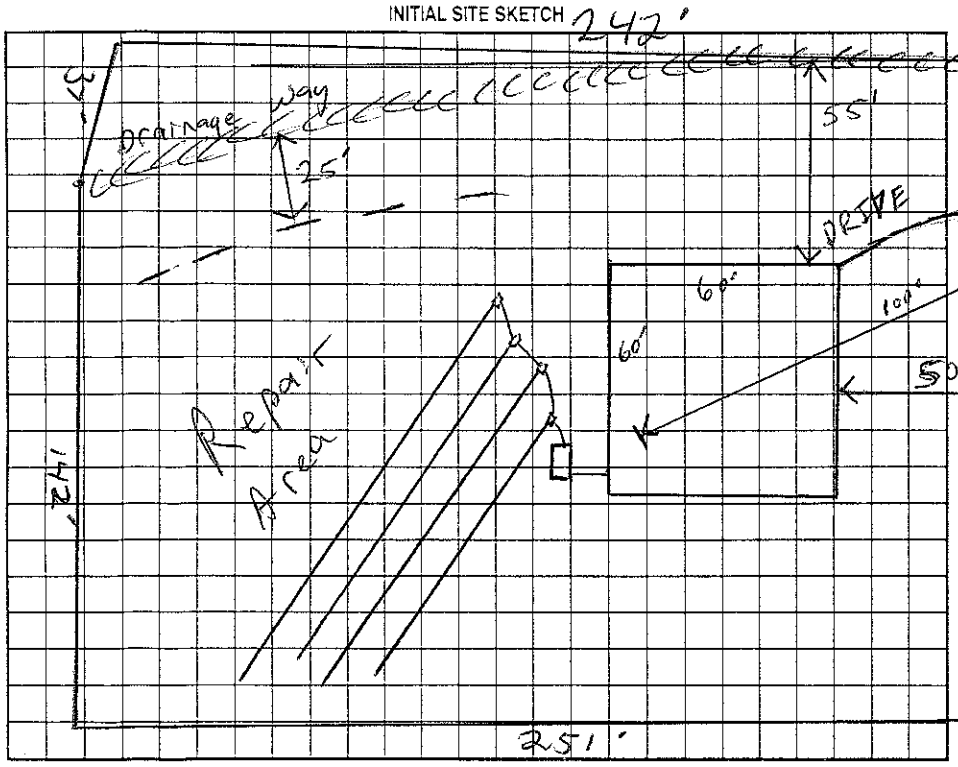

AS BUILT SKETCH

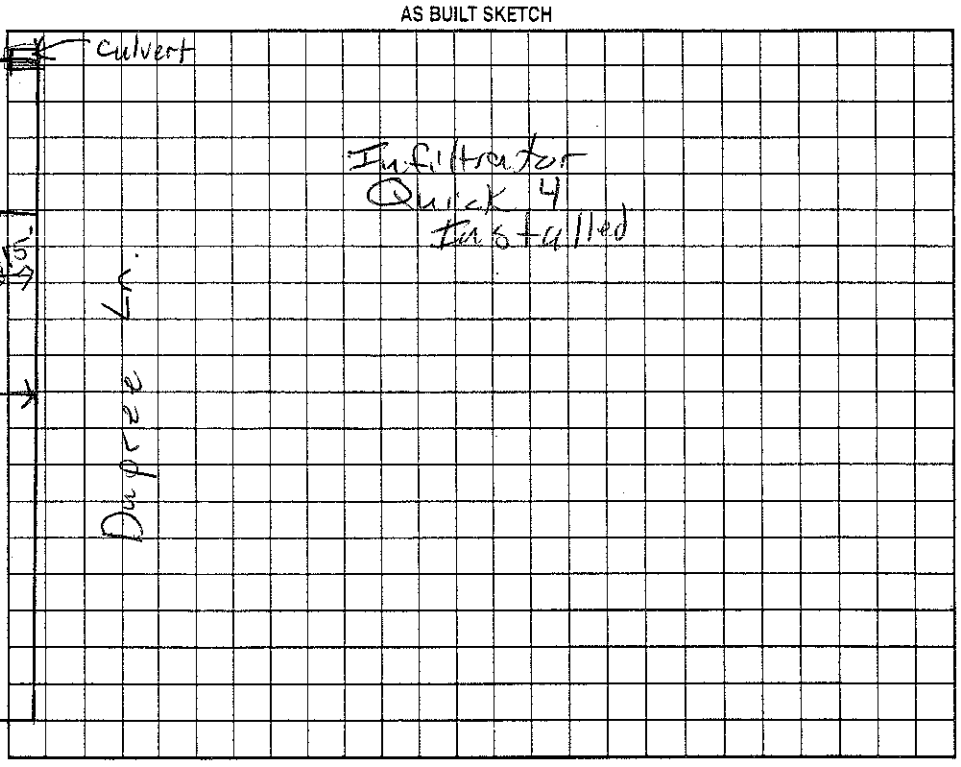

Permit can be suspended or revoked if any false information is supplied toward securing the permit/any unauthorized changes are made to the site/any unauthorized changes are made in the installation of the system. Improvement Permit with plat valid without expiration. Improvement Permit with site plan valid for sixty months. Authorization to Construct is valid for a period equal to that of Improvement Permit – not to exceed sixty months.

Signed: Melanie Allen date 2/4/05 Installed by: Larry Beam

Improvement Permit by: RS date 10/29/04 Operation Permit by: RS date 5/10/06

Authorization to Construct by: RS date 11/22/05 Existing System Inspection by: date

HEALTH DEPT. COPY: WHITE OWNER COPY (FINAL): YELLOW OWNER COPY (INITIAL): PINK