IREDELL COUNTY HEALTH DEPARTMENT

STATESVILLE 704-878-5305 MOORESVILLE 704-664-5281

IMPROVEMENT PERMIT / AUTHORIZATION TO CONSTRUCT / OPERATION PERMIT / EXISTING SYSTEM INSPECTION

PERMIT# 124027 PIN# ~~4679-72-2317.002~~ 4679224040.000 DATE 12/30/04

OWNER OR CONTRACTOR Paul Allen PHONE: Business 704 663 6905 Home

ADDRESS 318 Glenwood Dr. Mooresville NC 28115

LOCATION HWY 801, TL Dupree Ln, 2nd on Lt

SUBDIVISION Dupree Est. BLOCK / SECTION LOT 2 LOT AREA 1.00AC SITE CLASS. PS DESIGN FLOW 480 L.T.A.R. 0.3

Septic Tank: 1000 Gallons; STB 1067 Date 1-6-06
Pump Tank: 1000 Gallons; PT 274 Date 2-27-06
Pump Make: Little Giant Model Serial No.
Nitrification Field: No Fields 1 Square Feet 810 Linear Feet 270'
No Lines 5@54' Trench Width 24" & 8 FOC Max Trench Bottom Depth 36" Gravel Depth —

☒ New System ☐ Repair System Type: I, II, (III), IV, V, VI
System Description: PM Panel Block
Repair System Description: Pump Panel Block
Maintenance Agreement Required: ☐ Yes ☒ No

☒ House/Mod. Home No. Bedrooms 4
☐ Mobile Home No. Bathrooms
☐ Business No. Employees
☐ Other

Water Supply: ☒ Individual ☐ Public ☐ Community


☐ Slab ☒ Crawl Space ☐ Basement w/plumbing ☐ Basement wo/plumbing

Comments:/Conditions: 36" OR 9 FOC

1" = 50

Comments:/Conditions:

INITIAL SITE SKETCH

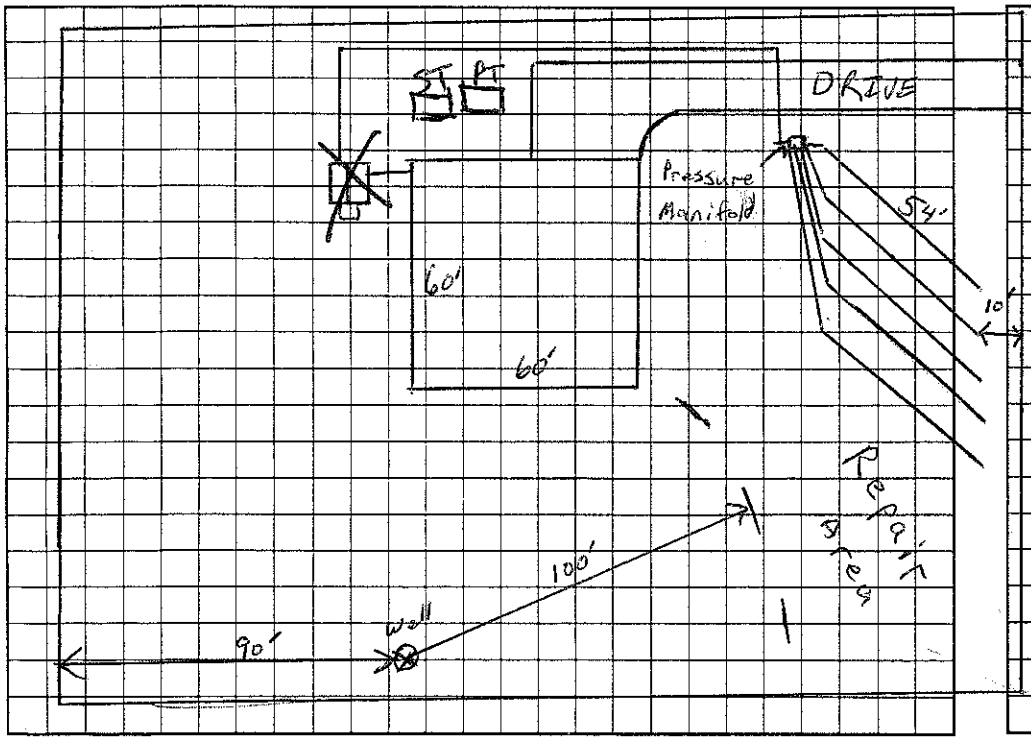

AS BUILT SKETCH



Permit can be suspended or revoked if any false information is supplied toward securing the permit/any unauthorized changes are made to the site/any unauthorized changes are made in the installation of the system. Improvement Permit with plat valid without expiration. Improvement Permit with site plan valid for sixty months. Authorization to Construct is valid for a period equal to that of Improvement Permit – not to exceed sixty months.

Signed: Melanie Allen date 2/4/05 Installed by: Richard Abernathy

Improvement Permit by: RS date 12/30/04 Operation Permit by: Marvin Dotson BS date 5/23/06

Authorization to Construct by: RS date 9/12/05 Existing System Inspection by: date

HEALTH DEPT. COPY: WHITE OWNER COPY (FINAL): YELLOW OWNER COPY (INITIAL): PINK