IREDELL COUNTY HEALTH DEPARTMENT

STATESVILLE 704-878-5305 MOORESVILLE 704-664-5281

IMPROVEMENT PERMIT / AUTHORIZATION TO CONSTRUCT / OPERATION PERMIT / EXISTING SYSTEM INSPECTION

PERMIT# 070792 PIN# ~~4679225579~~ PT 4679226598 DATE 1/29/98

OWNER OR CONTRACTOR Jeff Lipscomb PHONE: Business 391-9397 Home 567-0089

ADDRESS 1491 Mt. Ulla Hwy / 1085 Jones Rd. Mt. Ulla, NC 28125

LOCATION 801 N just past J Triplett Rd on left

SUBDIVISION _____ BLOCK / SECTION _____ LOT _____ LOT AREA 13 Acres SITE CLASS. PS DESIGN FLOW 450 gpd L.T.A.R. .63

Septic Tank: 1000 Gallons; STB 760 Date 8-23-98

Pump Tank: _____ Gallons; PT _____ Date _____

Pump Make: _____ Model _____ Serial No. _____

Nitrification Field: No Fields 1 Square Feet 1597 Linear Feet 532'

No Lines 4 at 133' ea Trench Width 36" Max Trench Bottom Depth 22" Gravel Depth 12"

☒ New System ☐ Repair System Type: I, (II), III, IV, V, VI

System Description: Gravity - Conventional

Repair System Description: Same

Maintenance Agreement Required: ☐ Yes ☒ No

☒ House/Mod. Home ☐ Mobile Home ☐ Business ☐ Other

No. Bedrooms 4 No. Bathrooms 2.5 No. Employees _____

☐ Slab ☒ Crawl Space ☐ Basement w/plumbing ☒ Basement wo/plumbing Partial


Water Supply: ☒ Individual ☐ Public ☐ Community

Comments:/Conditions: Existing "Bored Well" must be abandoned per State of North Carolina rules, prior to Installation of Septic System.

Comments:/Conditions: Keep Septic System at least 100' From "New" well, 5' from house (crawl space)

Scale 1:200

INITIAL SITE SKETCH

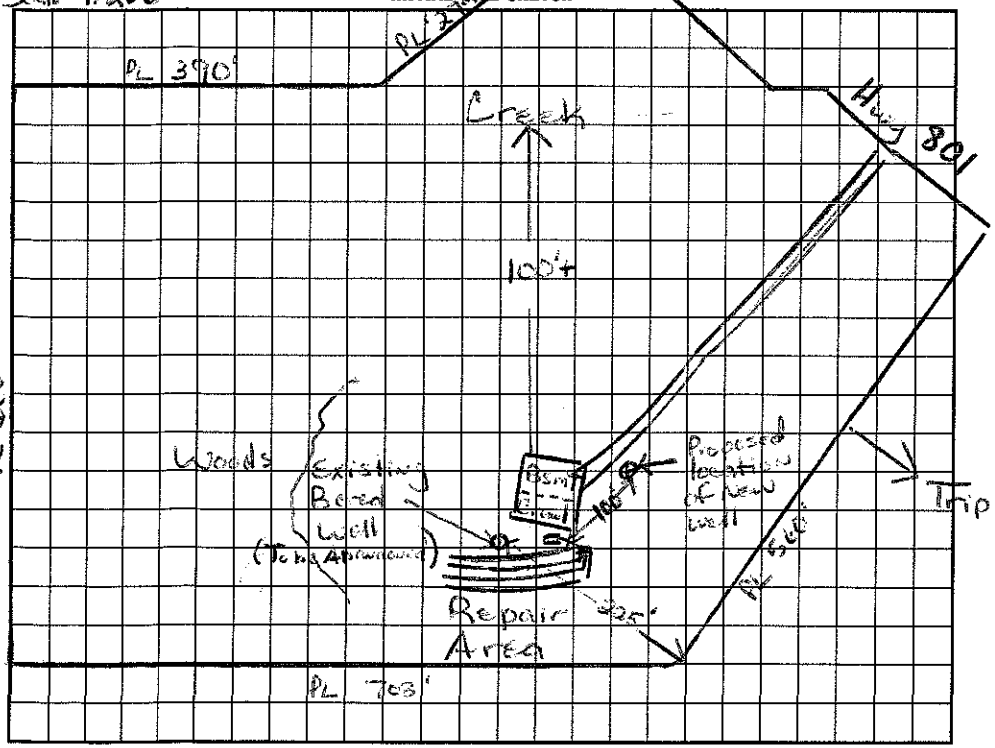

AS BUILT SKETCH

I understand that this permit can be suspended or revoked if any false information is supplied toward securing the permit/any unauthorized changes are made to the site/any unauthorized changes are made in the installation of the system. Improvement Permit with plat valid without expiration. Improvement Permit with site plan valid for sixty months. Authorization to Construct is valid for a period equal to that of Improvement Permit – not to exceed sixty months.

Signed: Stacy Lavery date 2-4-98 Installed by: Randy Miller

Improvement Permit by: Marina H. Dotson date 1/29/98 Operation Permit by: Wesley Sparks R.S. date 11/9/98

Authorization to Construct by: Marina H. Dotson date 1/29/98 Existing System Inspection by: _____ date _____

HEALTH DEPT. COPY: WHITE INSPECTION COPY (FINAL): GREEN OWNER COPY (FINAL): YELLOW INSPECTION COPY (INITIAL): PINK OWNER COPY (INITIAL): GOLD