IREDELL COUNTY HEALTH DEPARTMENT

STATESVILLE 704-878-5305 MOORESVILLE 704-664-5281

IMPROVEMENT PERMIT / AUTHORIZATION TO CONSTRUCT / OPERATION PERMIT / EXISTING SYSTEM INSPECTION

PERMIT# 134639 PIN# 4679281220 DATE 4-12-06

OWNER OR APPLICANT Kem Brown PHONE: Business 704-662-4206 Home 704-663-1745

ADDRESS 146 French Belk Rd Mt Ulla 28125

LOCATION 115 N TR Mazeppa TL Triplette Rd TR French Belk on right

SUBDIVISION NA BLOCK / SECTION ____ LOT ____ LOT AREA 2.15A SITE CLASS. PS DESIGN FLOW 360gpd L.T.A.R. .3gpd/ft²

Septic Tank: 1000 Gallons; STB 760 Date 2-13-06
Pump Tank: ____ Gallons; PT ____ Date ____
Pump Make: ____ Model ____ Serial No. ____
Nitrification Field: No Fields 1 Square Feet ____ Linear Feet 400
No Lines 5@80' Trench Width 36" Max Trench Bottom Depth 26"

☒ New System ☐ Repair ☐ Expansion System Type: I II III IV V VI
System Description: Conventional, gravity
Repair System Description: Conventional, gravity
Maintenance Agreement Required: ☐ Yes ☒ No
Gravel Depth 12" ☒ Gravity ☐ Pressure

☒ House/Mod. Home No. Bedrooms 3
☒ Mobile Home No. Persons ____
☐ Business No. Employees ____
☐ Other ____

Water Supply: ☒ Individual ☐ Public ☐ Community

☐ Slab ☒ Crawl Space ☐ Basement w/plumbing ☐ Basement wo/plumbing

Comments:/Conditions:


5 Trenches 3' x 80'
Disconnect & Remove water line below house, Route new water line above house

Comments:/Conditions:


Red Poly lok filter
Installed as per site sketch

1" = 100'

INITIAL SITE SKETCH

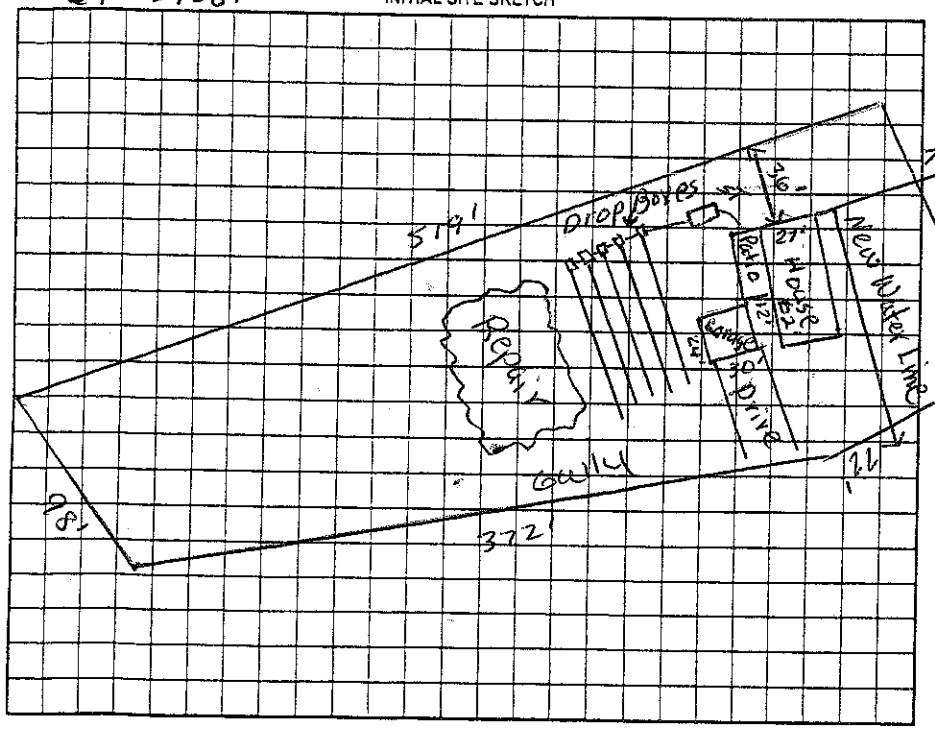

AS BUILT SKETCH

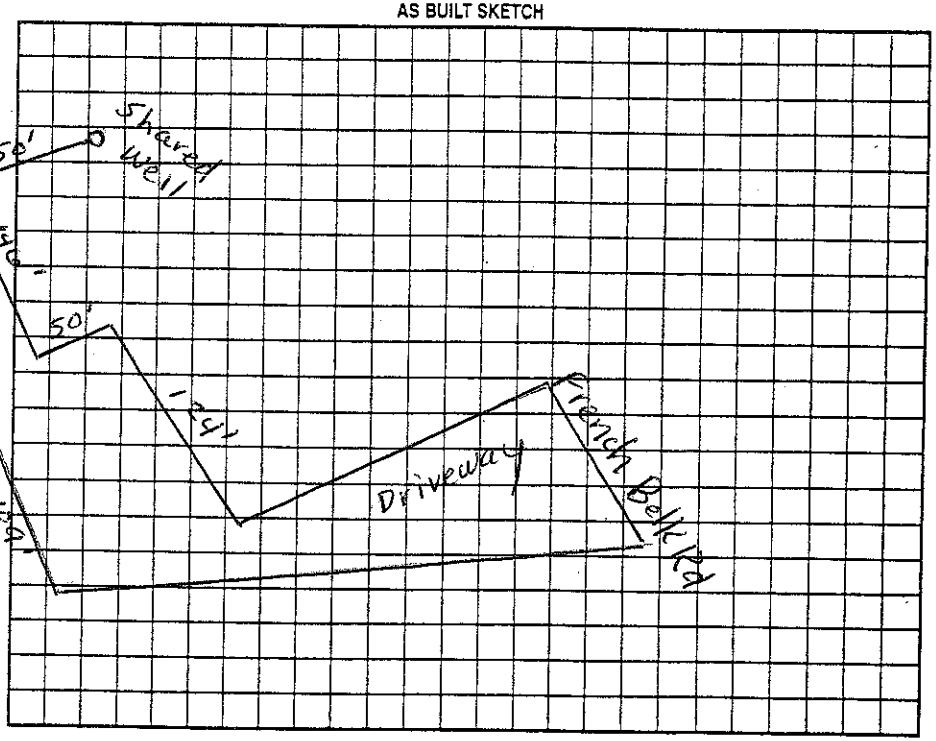

Permit can be suspended or revoked if any false information is supplied toward securing the permit/any unauthorized changes are made to the site/any unauthorized changes are made in the installation of the system. Improvement Permit with plat valid without expiration ☐ Improvement Permit with site plan valid for sixty months ☒ Authorization to Construct is valid for a period equal to that of Improvement Permit – not to exceed sixty months.

Signed: [signature] date 4/21/06 Installed by: Ray's Septic Tank

Improvement Permit by: Judy Melville date 4-12-06 Operation Permit by: Judy Melville date 6-8-06

Authorization to Construct by: Judy Melville date 4-12-06 Existing System Inspection by: ____ date ____

HEALTH DEPT. COPY: WHITE OWNER COPY (FINAL): YELLOW OWNER COPY (INITIAL): PINK