IREDELL COUNTY HEALTH DEPARTMENT

STATESVILLE 704-878-5305 MOORESVILLE 704-664-5281

IMPROVEMENT PERMIT / AUTHORIZATION TO CONSTRUCT / OPERATION PERMIT / EXISTING SYSTEM INSPECTION

PERMIT# 075027 PIN# ~~4679283394~~ 4679283538 DATE 7/09/98

OWNER OR CONTRACTOR CLIFFORD SETTLEMYER PHONE: Business Home 663-3741

ADDRESS 160 CONFEDERATE RD. MT ULLA NC 28125

LOCATION TRIPLETT RD - TR CONFEDERATE RD - ON RT # 164 CONFEDERATE (FRENCH BELK)

SUBDIVISION — BLOCK / SECTION — LOT — LOT AREA 3.72 AC SITE CLASS. LS DESIGN FLOW 360 L.T.A.R. .4

Septic Tank: EXISTING Gallons; STB Date

Pump Tank: Gallons; PT Date

Pump Make: Model Serial No.

Nitrification Field: No Fields 1 Square Feet 300 Linear Feet 100

No Lines 2@50' Trench Width 36" Max Trench Bottom Depth 36" Gravel Depth 12"

☑ New System ☐ Repair System Type: I, II, III, IV, V, VI

System Description: GRAVITY CONVENTIONAL

Repair System Description: SAME

Maintenance Agreement Required: ☐ Yes ☑ No

☐ House/Mod. Home ☑ Mobile Home ☐ Business ☐ Other

No. Bedrooms 3 No. Bathrooms 2 No. Employees


☐ Slab ☑ Crawl Space ☐ Basement w/plumbing ☐ Basement wo/plumbing

Water Supply: ☑ Individual ☐ Public ☐ Community

Comments:/Conditions:

Comments:/Conditions:

INITIAL SITE SKETCH

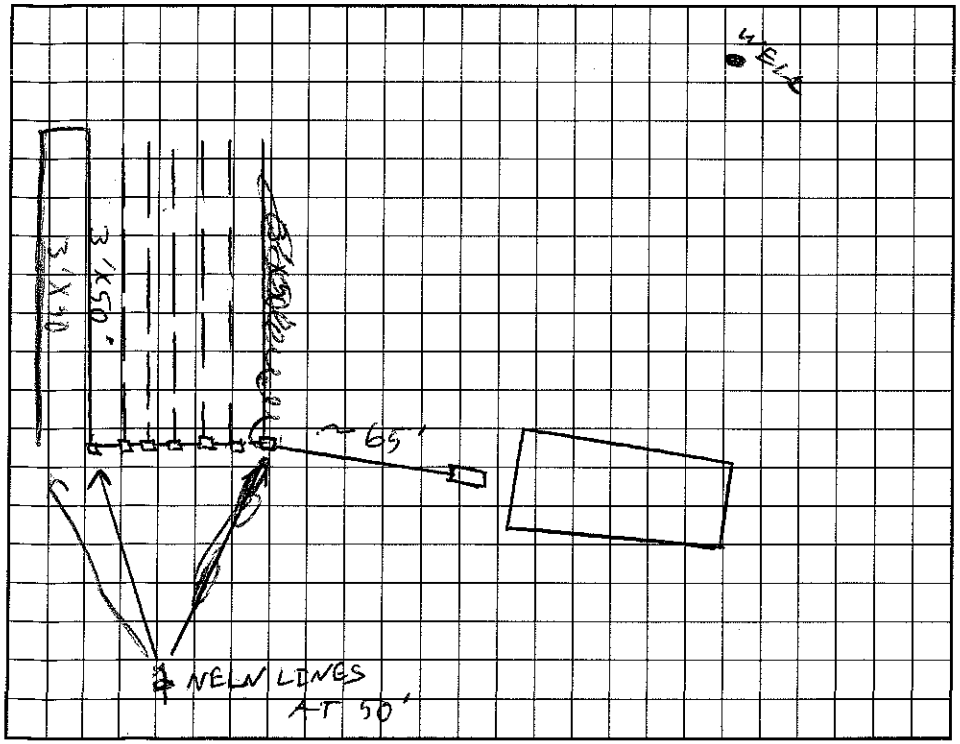

AS BUILT SKETCH

I understand that this permit can be suspended or revoked if any false information is supplied toward securing the permit/any unauthorized changes are made to the site/any unauthorized changes are made in the installation of the system. Improvement Permit with plat valid without expiration. Improvement Permit with site plan valid for sixty months. Authorization to Construct is valid for a period equal to that of Improvement Permit – not to exceed sixty months.

Signed: Clifford R. Settlemyer date

Improvement Permit by: C. Ray Freeman RS date 7/9/98

Authorization to Construct by: C. Ray Freeman RS date 7/9/98

Installed by: A1 DRILLING

Operation Permit by: C. Ray Freeman RS date 7/20/98

Existing System Inspection by: date

HEALTH DEPT. COPY: WHITE INSPECTION COPY (FINAL): GREEN OWNER COPY (FINAL): YELLOW INSPECTION COPY (INITIAL): PINK OWNER COPY (INITIAL): GOLD