4679293353

IREDELL COUNTY HEALTH DEPARTMENT

STATESVILLE 704-878-5305 MOORESVILLE 704-664-5281

IMPROVEMENT PERMIT / CERTIFICATE OF COMPLETION / OPERATION PERMIT / EXISTING SYSTEM INSPECTION

PROPERTY DESCRIPTION NO. 19418 DATE 9/20/94 TAX MAP NO. 4H-A-8 Watershed: ☐ Yes ☑ No

OWNER OR CONTRACTOR James Kevin Winecoff PHONE: Business _____ Home 663-3545

ADDRESS 2522 Charlotte Hwy Mooresville, NC. 28115

LOCATION Confederate Rd, ½ mile on ⓘ in field

SUBDIVISION N/A BLOCK / SECTION _____ LOT N/A LOT AREA ~3.9 Ac SITE CLASS. P DESIGN FLOW 360 L.T.A.R. .3

Septic Tank: 1000 Gallons; STB _____ Date _____

Pump Tank: _____ Gallons; PT _____ Date _____

Pump Make: _____ Model _____ Serial No. _____

Nitrification Field: No Fields 1 Square Feet 1200 Linear Feet 400

No Lines 4 Trench Width 36" Max Trench Bottom Depth 30" Gravel Depth 12"

☑ New System ☐ Repair System Type: I (II) III, IV, V, VI

System Description: CONV - DIST BOX

Repair System Description: _____

Maintenance Agreement Required: ☐ Yes ☑ No

☑ House/Mod. Home No. Bedrooms 3

☐ Mobile Home No. Bathrooms 2

☐ Business No. Employees _____

☐ Other _____


☐ Slab ☐ Crawl Space ☑ Basement w/plumbing ☐ Basement wo/plumbing

Water Supply: ☑ Individual ☐ Community ☐ Public

Comments: 238'


Trench depth 30", lines on slope contour

INITIAL SITE SKETCH

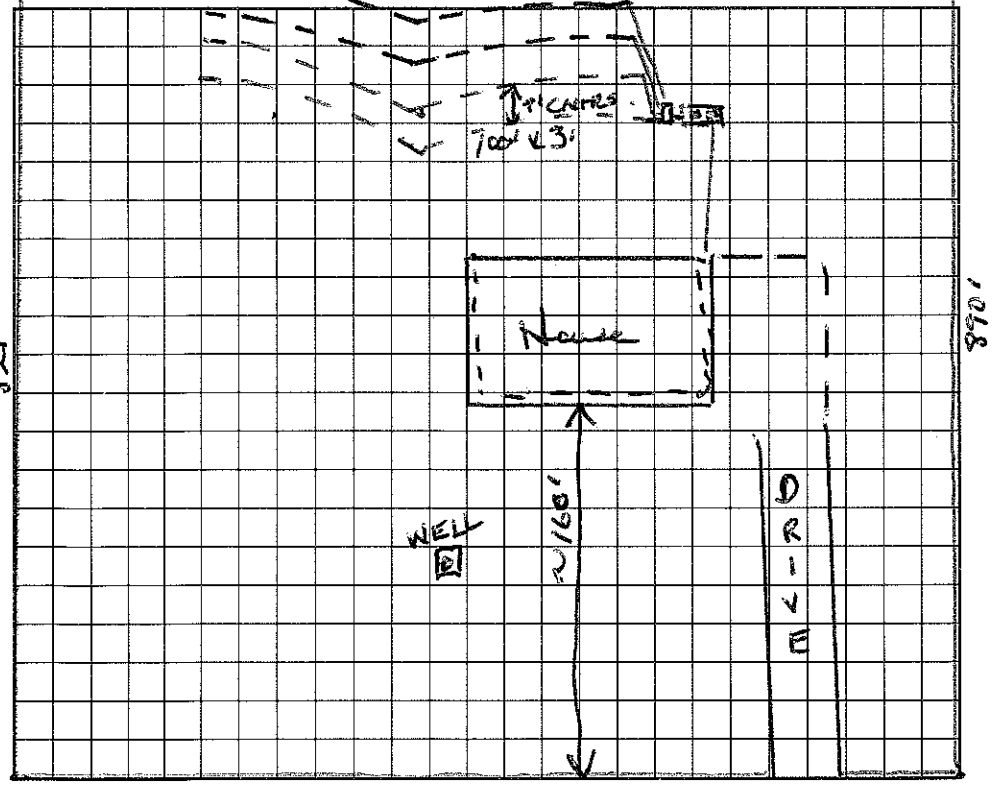

Comments:

AS BUILT SKETCH

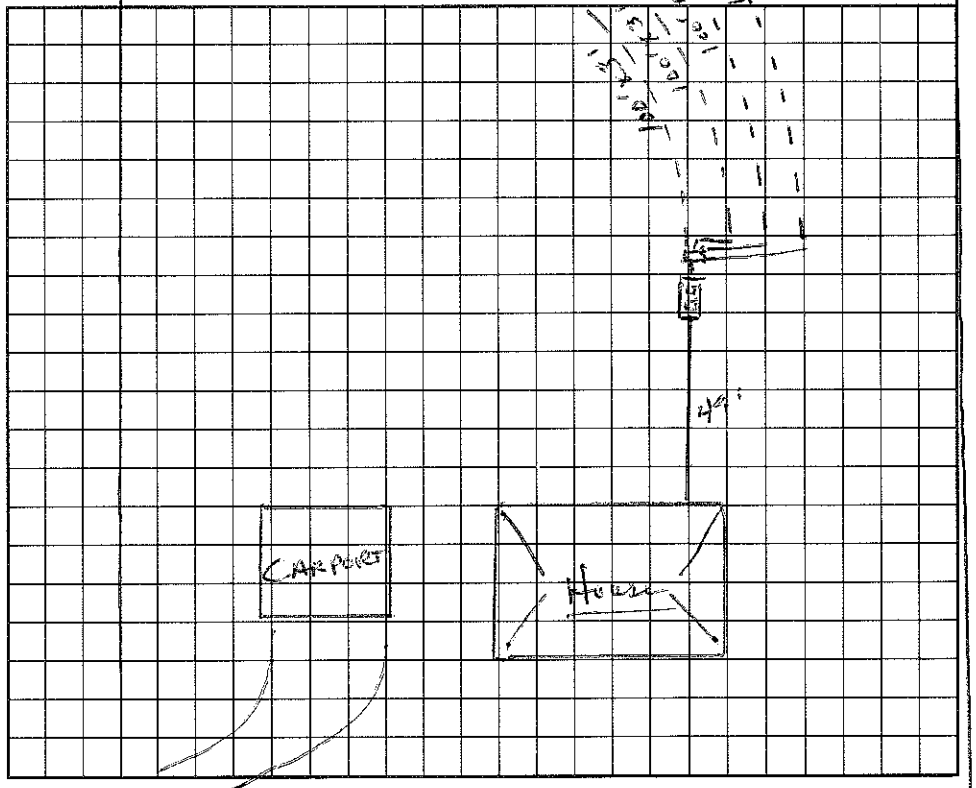

I understand that this permit can be suspended or revoked if any false information is supplied toward securing the permit/any unauthorized changes are made to the site/any unauthorized changes are made in the installation of the system. Improvement Permit is valid for 60 months from date of issuance.

Signed: James K Winecoff CONFEDERATE RD.

Improvement Permit by: Wesley Sparks RS date 9/20/94

Existing System Inspection by: _____ date _____

Installed by: Larry Beam CONFEDERATE RD.

Certificate of Completion by: Wesley Sparks RS. date 4/3/95

Operation Permit by: _____ date _____

HEALTH DEPT. COPY: WHITE INSPECTION COPY (FINAL): GREEN OWNER COPY (FINAL): YELLOW INSPECTION COPY (INITIAL): PINK OWNER COPY (INITIAL): GOLD