4679 299789

IREDELL COUNTY HEALTH DEPARTMENT

STATESVILLE 704-878-5305 MOORESVILLE 704-664-5281

IMPROVEMENT PERMIT / CERTIFICATE OF COMPLETION / OPERATION PERMIT / EXISTING SYSTEM INSPECTION

PROPERTY DESCRIPTION NO. Repair DATE 1/4/95 TAX MAP NO. N/A Watershed: ☑ Yes ☐ No

OWNER OR CONTRACTOR Ken Clonninger PHONE: Business _____ Home 663-5856

ADDRESS 203 Confederate Rd. Mooresville, NC

LOCATION Confederate Rd. Triplett to 4th house on L

SUBDIVISION N/A BLOCK / SECTION _____ LOT _____ LOT AREA ~ 1 3/4 ac. SITE CLASS. P DESIGN FLOW 360 L.T.A.R. _____

Septic Tank: 1000 Gallons; STB 794 Date 1/10/95

Pump Tank: _____ Gallons; PT _____ Date _____

Pump Make: _____ Model _____ Serial No. _____

Nitrification Field: No Fields 1 Square Feet 360 Linear Feet 120

No Lines 1 Trench Width 36" Max Trench Bottom Depth 36" Gravel Depth _____

☐ New System ☑ Repair System Type: I, ☑ II, III, IV, V, VI

System Description: Conv. - 0 Bed

Repair System Description: _____

Maintenance Agreement Required: ☐ Yes ☑ No

☑ House/Mod. Home No. Bedrooms 3

☐ Mobile Home No. Bathrooms 2

☐ Business No. Employees _____

☐ Other _____


☐ Slab ☑ Crawl Space ☐ Basement w/plumbing ☐ Basement wo/plumbing

Water Supply: ☑ Individual ☐ Community ☐ Public

Comments: Old tank has been maintained - tabby chute on original plan line with addition. Relocate tank in front of walk. Tree Roots.

Comments:

INITIAL SITE SKETCH

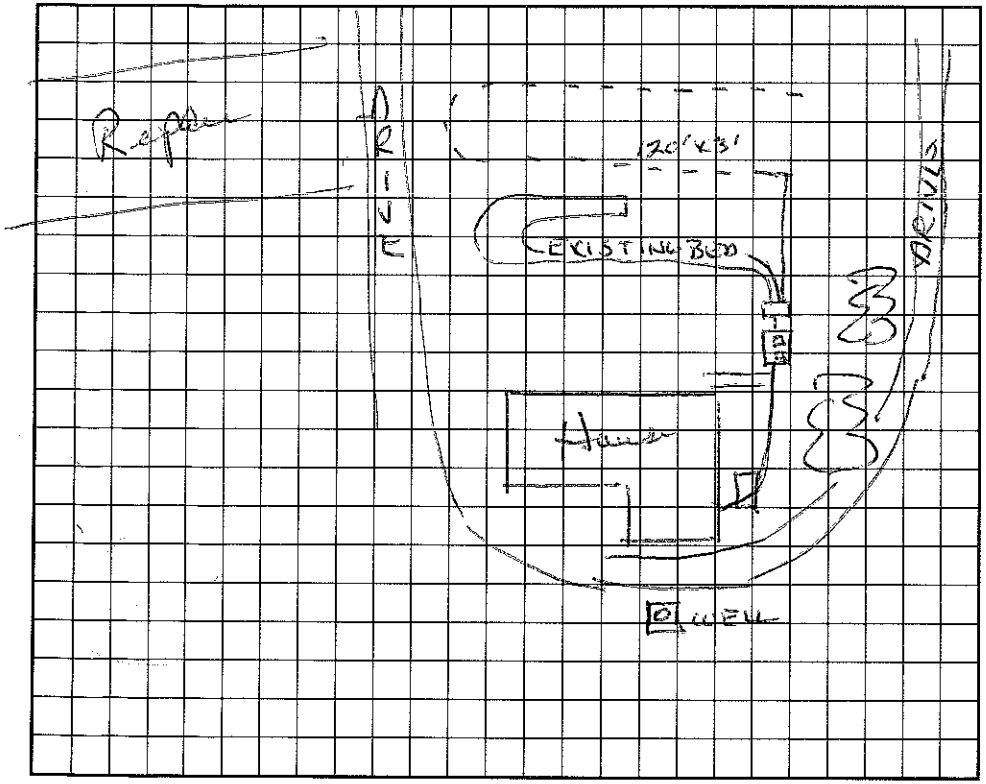

AS BUILT SKETCH

I understand that this permit can be suspended or revoked if any false information is supplied toward securing the permit/any unauthorized changes are made to the site/any unauthorized changes are made in the installation of the system. Improvement Permit is valid for 60 months from date of issuance.

Signed: X Kenneth E Clonninger

Improvement Permit by: Wesley Sparks R.S. date 1/4/95

Existing System Inspection by: _____ date _____

Installed by: Larry Beam

Certificate of Completion by: Wesley Sparks R.S. date 3/22/95

Operation Permit by: _____ date _____

HEALTH DEPT. COPY: WHITE INSPECTION COPY (FINAL): GREEN OWNER COPY (FINAL): YELLOW INSPECTION COPY (INITIAL): PINK OWNER COPY (INITIAL): GOLD