Site Address: 213 French Belk Rd - Mt. Ulla

IREDELL COUNTY HEALTH DEPARTMENT

STATESVILLE 704-878-5305 MOORESVILLE 704-664-5281

IMPROVEMENT PERMIT / AUTHORIZATION TO CONSTRUCT / OPERATION PERMIT / EXISTING SYSTEM INSPECTION

PERMIT# 138691 PIN# 4679299773 4679299789 ✓ DATE 10/24/06

OWNER OR APPLICANT JOHN DODSON PHONE: Business _____ Home _____

ADDRESS 125 SUMMERCHASE LN MOORESVILLE 28117

LOCATION HWY 115 N, RT MAZELLA, LT TRIPLETT, RT FRENCH BELK, PROP ON LT

SUBDIVISION Kenneth + Norma Cunningham BLOCK / SECTION _____ LOT -1- LOT AREA .7 ACRES SITE CLASS PS DESIGN FLOW 480gpd L.T.A.R. .30gpd/ft²

Septic Tank: 1600 + Gallons; STB 1007 Date 8-8-07

Pump Tank: _____ Gallons; PT _____ Date _____

Pump Make: _____ Model _____ Serial No. _____

Nitrification Field: No Fields 1 Square Feet 1200ft² Linear Feet 400'

No Lines 3@133' Trench Width 36" Max Trench Bottom Depth 36" Gravel Depth _____

☒ New System ☐ Repair ☐ Expansion System Type: I ☒ II III IV V VI

System Description: GRAVITY - 25% REDUCTION

Repair System Description: SAME

Maintenance Agreement Required: ☐ Yes ☒ No

☒ House/Mod. Home ☐ Mobile Home ☐ Business ☐ Other

No. Bedrooms 4 No. Persons _____ No. Employees _____


Water Supply: ☒ Individual ☐ Public ☐ Community

☒ Gravity ☐ Pressure ☐ Slab ☐ Crawl Space ☒ Basement w/plumbing ☐ Basement wo/plumbing

Comments:/Conditions: FOLLOW CONTOURS; DRAIN LINES 9' ON CENTER, TANK 15' OR MORE FROM BASEMENT

(BASEMENT ONLY IN 16'x73' AREA OF HOUSE)

INITIAL SITE SKETCH

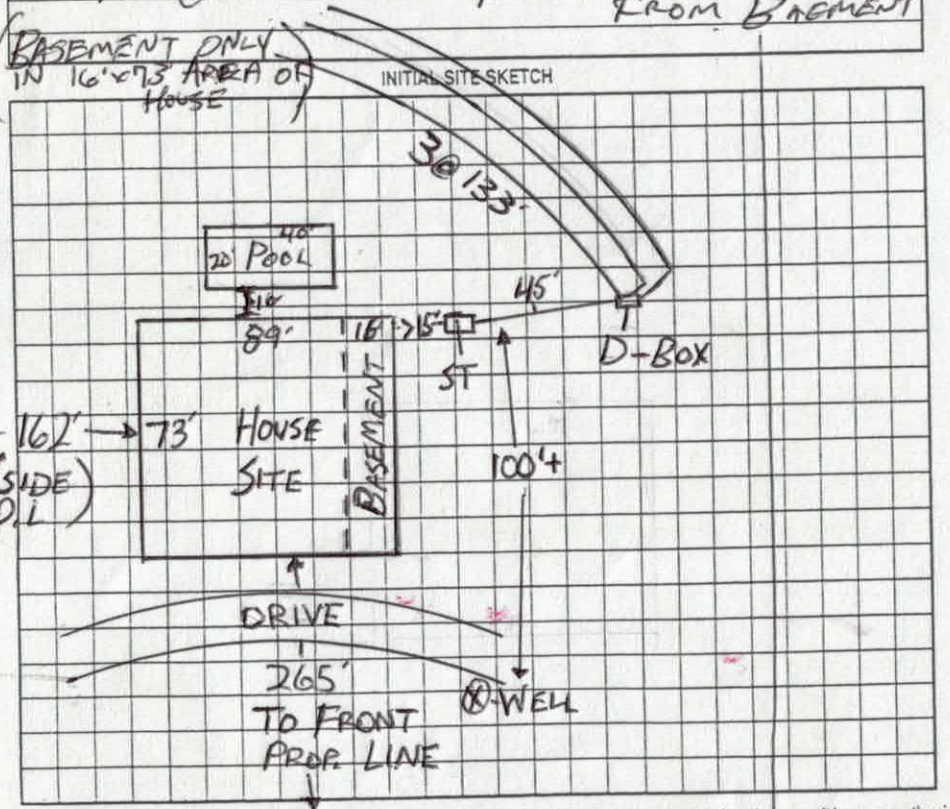

Comments:/Conditions: Used Quick 4 for Drainfield and used Built in "Drop boxes"

AS BUILT SKETCH

Installed As Drawn

Permit can be suspended or revoked if any false information is supplied toward securing the permit/any unauthorized changes are made to the site/any unauthorized changes are made in the installation of the system. Improvement Permit with plat valid without expiration ☐ Improvement Permit with site plan valid for sixty months ☒ Authorization to Construct is valid for a period equal to that of Improvement Permit – not to exceed sixty months.

Signed: _____ date 10/26/06 Installed by: Wayne Lantz RS

Improvement Permit by: _____ date 10/25/06 Operation Permit by: _____ date 10/2/07

Authorization to Construct by: _____ date 10/25/06 Existing System Inspection by: _____ date _____

HEALTH DEPT. COPY: WHITE OWNER COPY (FINAL): YELLOW OWNER COPY (INITIAL): PINK