IREDELL COUNTY HEALTH DEPARTMENT

STATESVILLE 704-878-5305 MOORESVILLE 704-664-5281

IMPROVEMENT PERMIT / AUTHORIZATION TO CONSTRUCT / OPERATION PERMIT / EXISTING SYSTEM INSPECTION

PERMIT# 13893T PIN# ~~4679318736~~ 4679317550 DATE 11-6-06

OWNER OR APPLICANT T & E Dev. PHONE: Business ~~704~~ 202-9595 Home

ADDRESS 112 Vista Bluff Ln Mooresville, NC 28117

LOCATION Hwy 801 TR Wiggins Rd TR Kerri Ln property on right

SUBDIVISION Kerri Plantation BLOCK / SECTION S LOT 12 LOT AREA 1.17 Acre SITE CLASS. PS DESIGN FLOW 480gpd L.T.A.R. .3

Septic Tank: 1000 Gallons; STB 760 Date 4-23-13

Pump Tank: Gallons; PT Date

Pump Make: Model Serial No.

Nitrification Field: No Fields 1 Square Feet 1,200' Linear Feet 400'

No Lines 5@80' Trench Width 36 Max Trench Bottom Depth 36" Gravel Depth N/A

☒ New System ☐ Repair ☐ Expansion System Type: I II III IV V VI

System Description: Gravity-Conventional/Accepted

Repair System Description: PM+25% Reduction

Maintenance Agreement Required: ☐ Yes ☐ No

☒ House/Mod. Home ☐ Mobile Home ☐ Business ☐ Other

No. Bedrooms 4 No. Persons No. Employees

Water Supply: ☐ Individual ☐ Public ☐ Community

☒ Gravity ☐ Pressure ☐ Slab ☒ Crawl Space ☐ Basement w/plumbing ☐ Basement wo/plumbing


Comments/Conditions:

Scale 1:60

See attached plan

Comments/Conditions: ~~A~~ Note: "Accepted" means 25% Reduction

INITIAL SITE SKETCH

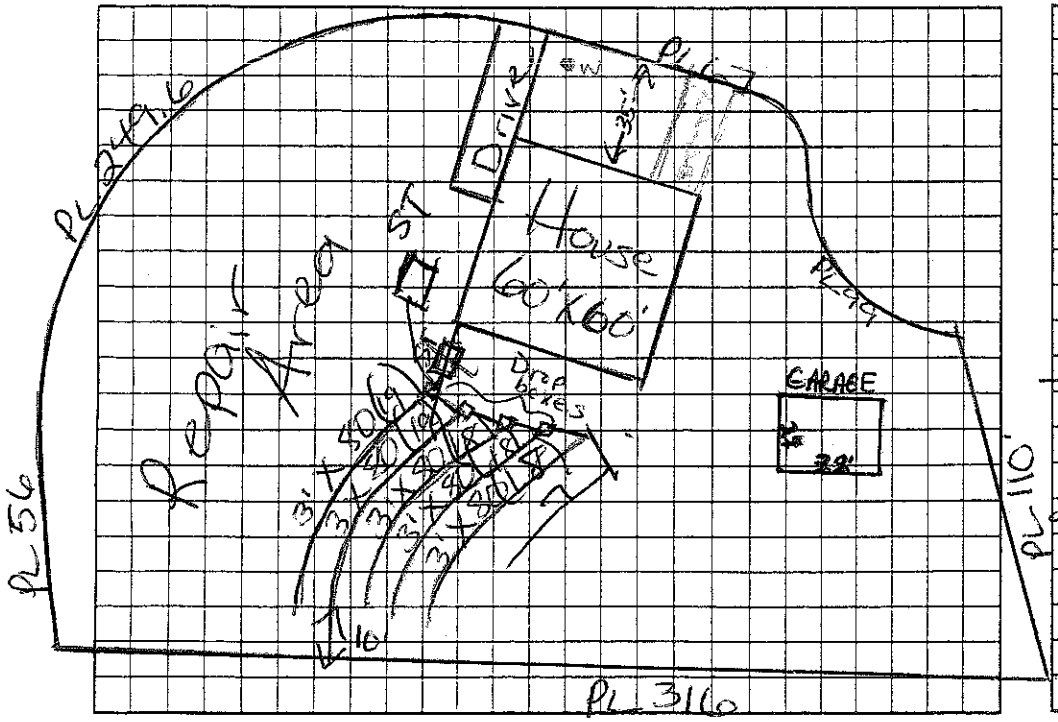

AS BUILT SKETCH

+ Used Quick 4 Infiltrator
+ Installed in 6 lines
Serial distribution
+ Lowest line ~ 28'
+ Supply line ~ 4ft off Patio & 9ft off House

THE PROPOSED DECK (34'x6') ADDITION DOES NOT APPEAR TO IMPACT THE EXISTING SEPTIC SYSTEM. IT WILL REMAIN 5' FROM SEPTIC SUPPLY LINE.

8/12/14

The proposed / existing 24'x 32' GARAGE addition does not appear to impact the existing septic system.

**NOTE:

R.S.

Date: 2-5-14

ICHD-Environmental Health Division

Permit can be suspended or revoked if any false information is supplied toward securing the permit/any unauthorized changes are made to the site/any unauthorized changes are made in the installation of the system. Improvement Permit with plat valid without expiration ☐ Improvement Permit with site plan valid for sixty months ☐ Authorization to Construct is valid for a period equal to that of Improvement Permit – not to exceed sixty months.

Signed: date 12/14/06 Installed by: Gurley Grading

Improvement Permit by: Maria Dotson RS date 11/6/06 Operation Permit by: Maria Dotson RS date 8/30/13

Authorization to Construct by: Judy Melville date 5-22-13 Existing System Inspection by: date

HEALTH DEPT. COPY: WHITE OWNER COPY (FINAL): YELLOW OWNER COPY (INITIAL): PINK