IREDELL COUNTY HEALTH DEPARTMENT

STATESVILLE 704-878-5305 MOORESVILLE 704-664-5281

IMPROVEMENT PERMIT / AUTHORIZATION TO CONSTRUCT / OPERATION PERMIT / EXISTING SYSTEM INSPECTION

PERMIT# 138937 PIN# 4679318736 4679317550 DATE 11-6-06

OWNER OR APPLICANT T & E Dev. PHONE: Business 704 202-9595 Home

ADDRESS 112 Vista Bluff Ln Mooresville, NC 28117

LOCATION Hwy 801 TR Wiggins Rd TR Kerri Ln property on right

SUBDIVISION Kerri Plantation BLOCK / SECTION LOT 12 LOT AREA 1.17 Acre SITE CLASS. PS DESIGN FLOW 480gpd L.T.A.R. .3

Septic Tank: 1000 Gallons; STB 760 Date 4-23-13
Pump Tank: Gallons; PT Date
Pump Make: Model Serial No.
Nitrification Field: No Fields 1 Square Feet 1,200' Linear Feet 400'
No Lines 5@80' Trench Width 36" Max Trench Bottom Depth 36" Gravel Depth N/A ☒ Gravity ☐ Pressure

☒ New System ☐ Repair ☐ Expansion System Type: I II III IV V VI
System Description: Gravity-Conventional Accepted
Repair System Description: PM-25% Reduction
Maintenance Agreement Required: ☐ Yes ☐ No

☒ House/Mod. Home ☐ Mobile Home ☐ Business ☐ Other
No. Bedrooms 4 No. Persons No. Employees


Water Supply: ☐ Individual ☐ Public ☐ Community

☐ Slab ☒ Crawl Space ☐ Basement w/plumbing ☐ Basement wo/plumbing

Comments:/Conditions:
Scale 1:60
See attached plan

Comments:/Conditions:
* Note: "Accepted" means 25% Reduction

INITIAL SITE SKETCH

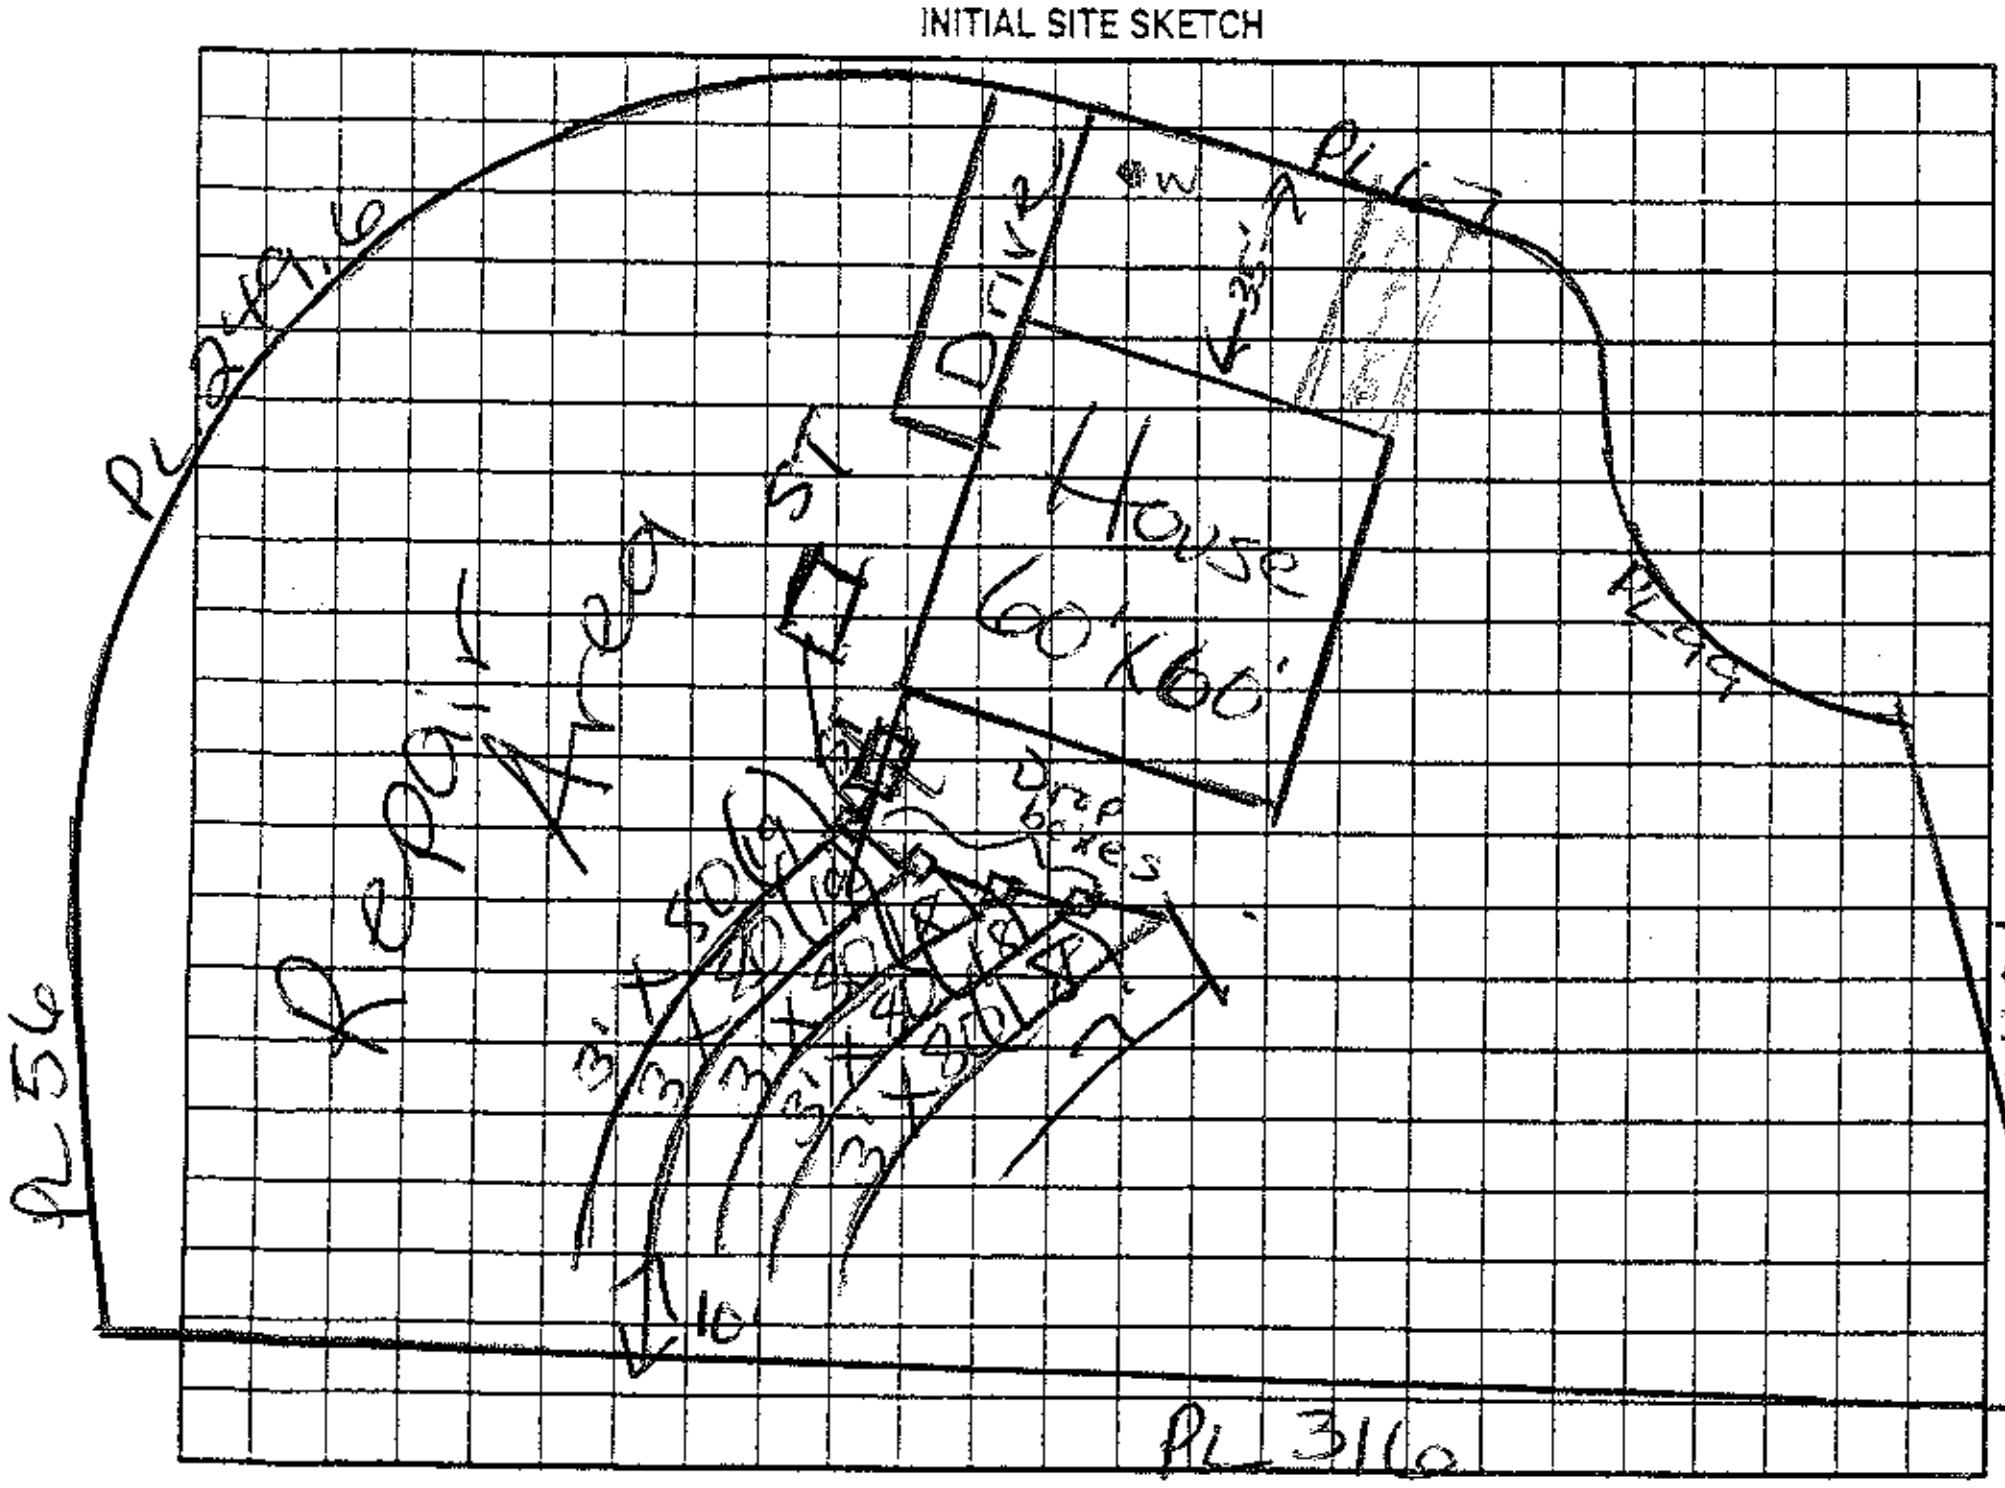

AS BUILT SKETCH

Used Quick 4 Infiltrator
Installed in 6 lines
Serial distribution
Lowest line ~ 28'
(Supply line ~ 4ft off Patio & 9ft off House)

Permit can be suspended or revoked if any false information is supplied toward securing the permit/any unauthorized changes are made to the site/any unauthorized changes are made in the installation of the system. Improvement Permit with plat valid without expiration ☐ Improvement Permit with site plan valid for sixty months ☐ Authorization to Construct is valid for a period equal to that of Improvement Permit – not to exceed sixty months.

Signed: Julie [signature] date 12/14/06 Installed by: Gunter Grading

Improvement Permit by: Maria H Dolson RS date 11/6/06 Operation Permit by: Maria Dolson RS date 8/30/13

Authorization to Construct by: [signature] date 5-22-13 Existing System Inspection by: date

HEALTH DEPT. COPY: WHITE OWNER COPY (FINAL): YELLOW OWNER COPY (INITIAL): PINK