IREDELL COUNTY HEALTH DEPARTMENT

Statesville Office (704) 878-5305 Mooresville Office (704) 660-3625 PERMIT # 181258

IMPROVEMENT PERMIT / AUTHORIZATION TO CONSTRUCT / OPERATION PERMIT / EXISTING SYSTEM

PIN # 4679-32-5302

APPLICANT: Jonathan McConnell APPLICANT ADDRESS: 1206 Assembly St. Belmont NC 28012

SITE ADDRESS: 1520 Mt. Ulla Hwy Mooresville NC 28115 PHONE: 704-400-5944 ALT. PHONE:


SITE DIRECTIONS: Mt. Ulla Hwy (Hwy 801) E, Past Triplett Rd on Rt, between 1528 & 1512 Mt. Ulla Hwy

SUBDIVISION: SECTION: LOT # LOT AREA: 2.0 ac DESIGN FLOW: 480 gpd L.T.A.R.: 0.3


Septic Tank	1000 (gal)	STB 794	Date 1-8-14	☑ New System ☐ Repair ☐ Expansion	System Type: I II (III) IV V VI	☑ Residence	No. Bedrooms	4	Water Supply
Pump Tank	(gal)	PT	Date	System Description:	Gravity 25% Reduction	☐ Business	No. Persons	8	☑ Private
Pump Make	Model		Serial #	Repair System Description:	Gravity 25% Reduction	☐ Other	No. Employees		☐ Public
# Nitrification Fields	1 # Lines 3		Linear Ft: 400	Maintenance Agreement Required:	☐ YES ☑ NO	☐ Slab	☑ Crawl Space		☐ Community
Trench Width	36" Max. Trench Bottom Depth 18"		Gravel Depth N/A	☑ GRAVITY	☐ PRESSURE	☐ Basement w/plumbing	☐ Basement w/o plumbing		

Comments / Conditions: 18" Trench Bottom, Keep lines on Contour

INITIAL SITE SKETCH

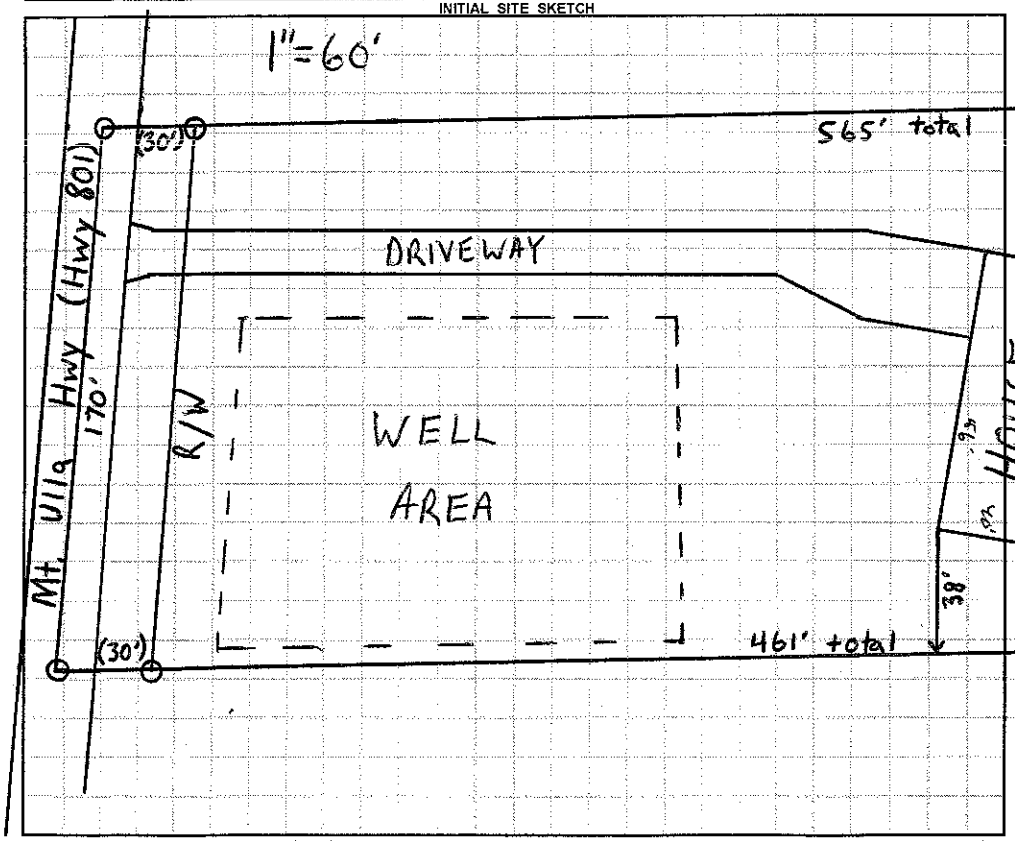

AS BUILT SKETCH

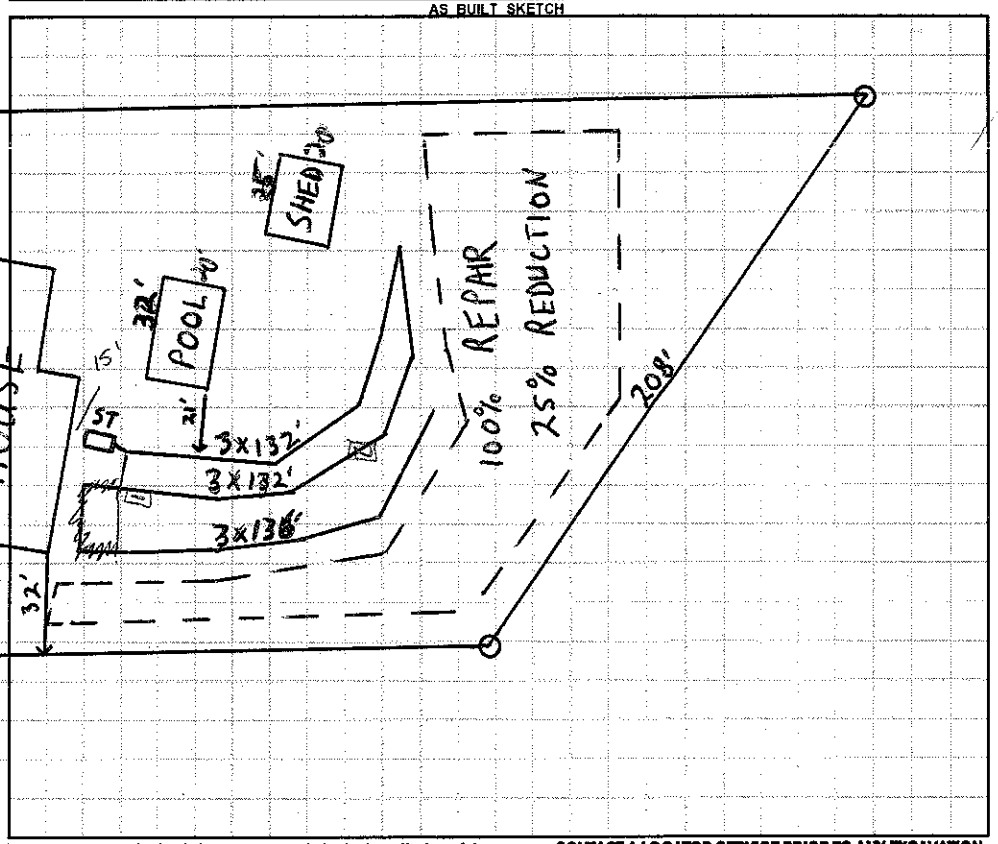

Permit can be suspended or revoked if any false information is supplied toward securing the permit / any unauthorized changes are made to the site / any unauthorized changes are made in the installation of the system. **CONTACT A LOCATOR SERVICE PRIOR TO ANY EXCAVATION**

☐ **IMPROVEMENT PERMIT** *with plat valid without expiration.* ☑ **IMPROVEMENT PERMIT** *with site plan valid for 60 mos.* ☑ **AUTHORIZATION TO CONSTRUCT** *valid for period equal to IMPROVEMENT PERMIT--not to exceed 60 mo.*

Owner / Applicant Signature: Date: 11-1-13 Installed by: Wendell?

IMPROVEMENT PERMIT by: Date: 10-30-13 OPERATION PERMIT by: Date:

AUTHORIZATION TO CONSTRUCT by: Date: 2-17-14 Existing System Inspected by: Date:

RECEIVED MAR 21 2014

Health Dept. Copy - WHITE Applicant (Final Approval) - YELLOW Applicant (Conditional Approval) - PINK