4679335086

IREDELL COUNTY HEALTH DEPARTMENT

STATESVILLE 704-878-5305 MOORESVILLE 704-664-5281

IMPROVEMENT PERMIT / CERTIFICATE OF COMPLETION / OPERATION PERMIT / EXISTING SYSTEM INSPECTION

PROPERTY DESCRIPTION NO. _____ DATE April 24, 95 TAX MAP NO. _____ Watershed: ☐ Yes ☐ No

OWNER OR CONTRACTOR Robert Daggenhart PHONE: Business _____ Home 663-4764

ADDRESS 156 Mt Ulla Hwy, Mooresville

LOCATION 801 N 4th house on left past junction w/ Triplett Road

SUBDIVISION _____ BLOCK / SECTION _____ LOT _____ LOT AREA _____ SITE CLASS. PS DESIGN FLOW 240 gpd L.T.A.R. _____

Septic Tank: Existing Gallons; STB _____ Date _____

Pump Tank: _____ Gallons; PT _____ Date _____

Pump Make: _____ Model _____ Serial No. _____

Nitrification Field: No. Fields 1 Square Feet 600+ Linear Feet 200+

No Lines 3 in bed Trench Width 9'+ Max Trench Bottom Depth as needed Gravel Depth 12"+

☐ New System ☑ Repair System Type: I, II, III, IV, V, VI

System Description: gravel trench - terra cotta

Repair System Description: 1 gravel bed

Maintenance Agreement Required: ☐ Yes ☑ No

☑ House/Mod. Home No. Bedrooms 2

☐ Mobile Home No. Bathrooms 1-2

☐ Business No. Employees ____

☐ Other _____

☐ Slab ☑ Crawl Space ☐ Basement w/plumbing ☐ Basement wo/plumbing


Water Supply: ☑ Individual ☐ Community ☐ Public

Comments: Can install 12'x70' if desired.

Check tank for "Tee".

Comments: Substantially as shown

INITIAL SITE SKETCH

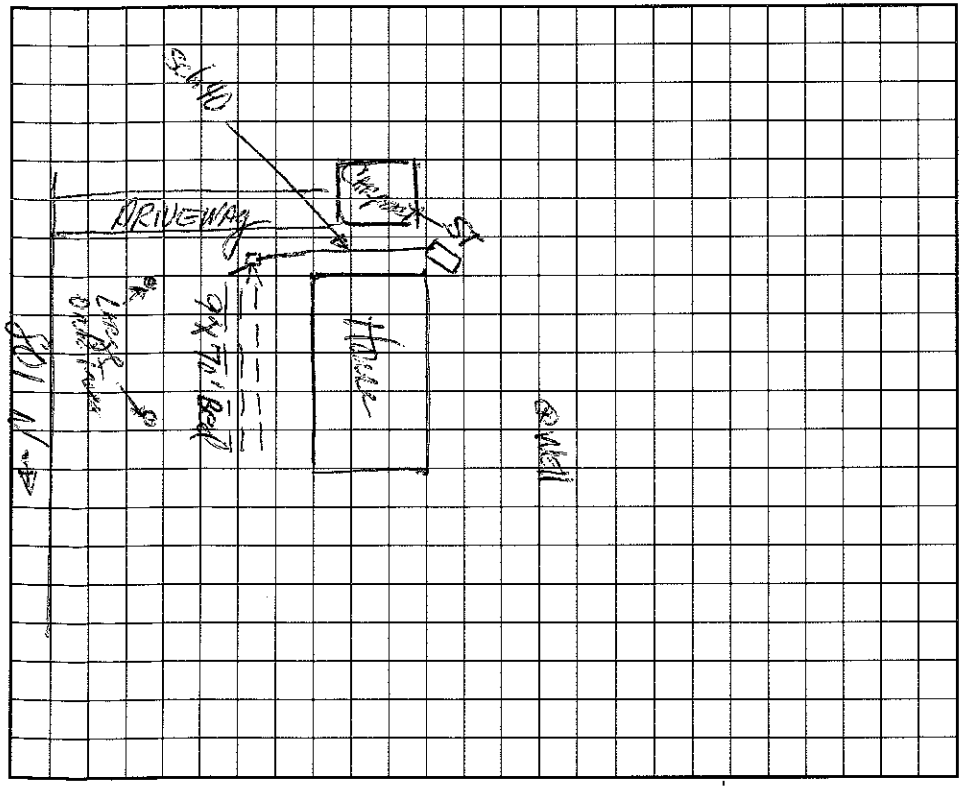

AS BUILT SKETCH

I understand that this permit can be suspended or revoked if any false information is supplied toward securing the permit/any unauthorized changes are made to the site/any unauthorized changes are made in the installation of the system. Improvement Permit is valid for 60 months from date of issuance.

Signed: X Robert Daggenhart

Improvement Permit by: [signature] date 4/24/95

Existing System Inspection by: _____ date _____

Installed by: Larry Beam

Certificate of Completion by: [signature] date 5/3/95

Operation Permit by: _____ date _____

HEALTH DEPT. COPY: WHITE INSPECTION COPY (FINAL): GREEN OWNER COPY (FINAL): YELLOW INSPECTION COPY (INITIAL): PINK OWNER COPY (INITIAL): GOLD