4679380976

IREDELL COUNTY HEALTH DEPARTMENT

STATESVILLE 704-878-5305 MOORESVILLE 704-664-5281

IMPROVEMENT PERMIT / CERTIFICATE OF COMPLETION / OPERATION PERMIT / EXISTING SYSTEM INSPECTION

PROPERTY DESCRIPTION NO. 18596 DATE 6/2/94 TAX MAP NO. 4H 2A 5 Watershed: ☑ Yes ☐ No

OWNER OR CONTRACTOR Allen Oliphant PHONE: Business _____ Home 664-2795

ADDRESS Rt 5 Box 966 Mooresville NC 28115

LOCATION Confederate Rd. Trailer off 801 N (R) on Confederate ~.5mi on (R) in field

SUBDIVISION Twin Brooks BLOCK / SECTION _____ LOT 5 LOT AREA ~4Ac SITE CLASS. P DESIGN FLOW 480 L.T.A.R. .125-.3

Septic Tank: 1000 Gallons; STB 794 Date 9/17/94

Pump Tank: _____ Gallons; PT _____ Date _____

Pump Make: _____ Model _____ Serial No. _____

Nitrification Field: No Fields 1 Square Feet 1600 Linear Feet 533

No Lines 4 Trench Width 3' Max Trench Bottom Depth 28" Gravel Depth 12"

☑ New System ☐ Repair System Type: I, II, III, IV, V, VI

System Description: CONV - DIST BOX - SPEED

Repair System Description: LEVELERS

Maintenance Agreement Required: ☐ Yes ☑ No

☑ House/Mod. Home No. Bedrooms 4

☐ Mobile Home No. Bathrooms 3

☐ Business No. Employees _____

☐ Other _____


☐ Slab ☐ Crawl Space ☑ Basement w/plumbing ☐ Basement wo/plumbing

Water Supply: ☑ Individual ☐ Community ☐ Public

Comments: Follow contour Keep trench depth no more than 28" deep

Comments: Installed essentially as shown on IP.

INITIAL SITE SKETCH

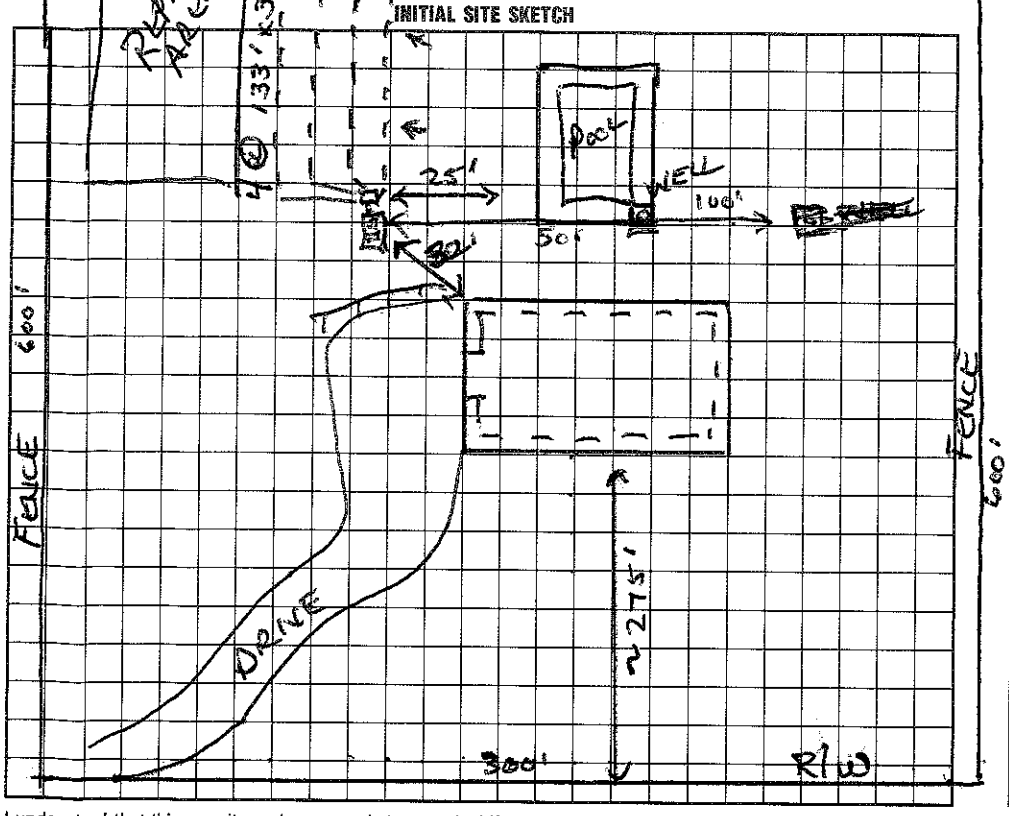

AS BUILT SKETCH

I understand that this permit can be suspended or revoked if any false information is supplied toward securing the permit/any unauthorized changes are made to the site/any unauthorized changes are made in the installation of the system. Improvement Permit is valid for 60 months from date of issuance.

Signed: _____

Improvement Permit by: Wesley Sparks R.S. date 6/2/94

Existing System Inspection by: _____ date _____

Installed by: Larry Beam

Certificate of Completion by: Wesley Sparks R.S. date 11/23/94

Operation Permit by: _____ date _____

HEALTH DEPT. COPY: WHITE INSPECTION COPY (FINAL): GREEN OWNER COPY (FINAL): YELLOW INSPECTION COPY (INITIAL): PINK OWNER COPY (INITIAL): GOLD