IREDELL COUNTY HEALTH DEPARTMENT

STATESVILLE 704-878-5305 MOORESVILLE 704-664-5281

IMPROVEMENT PERMIT / CERTIFICATE OF COMPLETION / OPERATION PERMIT / EXISTING SYSTEM INSPECTION

PROPERTY DESCRIPTION NO. 20946 DATE 5/10/95 TAX MAP NO. 4H - 2 - A - 3 4679381043 Watershed: ☐ Yes ☑ No

OWNER OR CONTRACTOR ~~W B Construction~~ CARL TOMPKINS PHONE: Business ______ Home 873-1844

ADDRESS 475 Oswalt Amity Rd. Troutman, NC. 28166

LOCATION ~~Confederate Rd.~~ on (R) 190 French Belk Rd.

SUBDIVISION Twin Brooks BLOCK / SECTION ______ LOT 3 LOT AREA ~10 Ac. SITE CLASS. P DESIGN FLOW 480 L.T.A.R. .3

Septic Tank: 1000 Gallons; STB 1012 Date 4/29/95

Pump Tank: 1000 Gallons; PT 17 Date 1/20/96

Pump Make: Gould Model WE1012-H Serial No. 2761591

Nitrification Field: No Fields 1 Square Feet 1600 Linear Feet 533

No Lines 4 Trench Width 36" Max Trench Bottom Depth 36" Gravel Depth 12"

☑ New System ☐ Repair System Type: I, II, (III), IV, V, VI

System Description: Pressure - Conventional

Repair System Description: Same

Maintenance Agreement Required: ☑ Yes ☐ No 5 YR.

☐ Slab ☐ Crawl Space ☑ Basement w/plumbing ☐ Basement wo/plumbing

☑ House/Mod. Home No. Bedrooms 4

☐ Mobile Home No. Bathrooms 3

☐ Business No. Employees ______


☐ Other ______

Water Supply: ☐ Individual ☐ Community ☐ Public


Comments:

Comments:

INITIAL SITE SKETCH

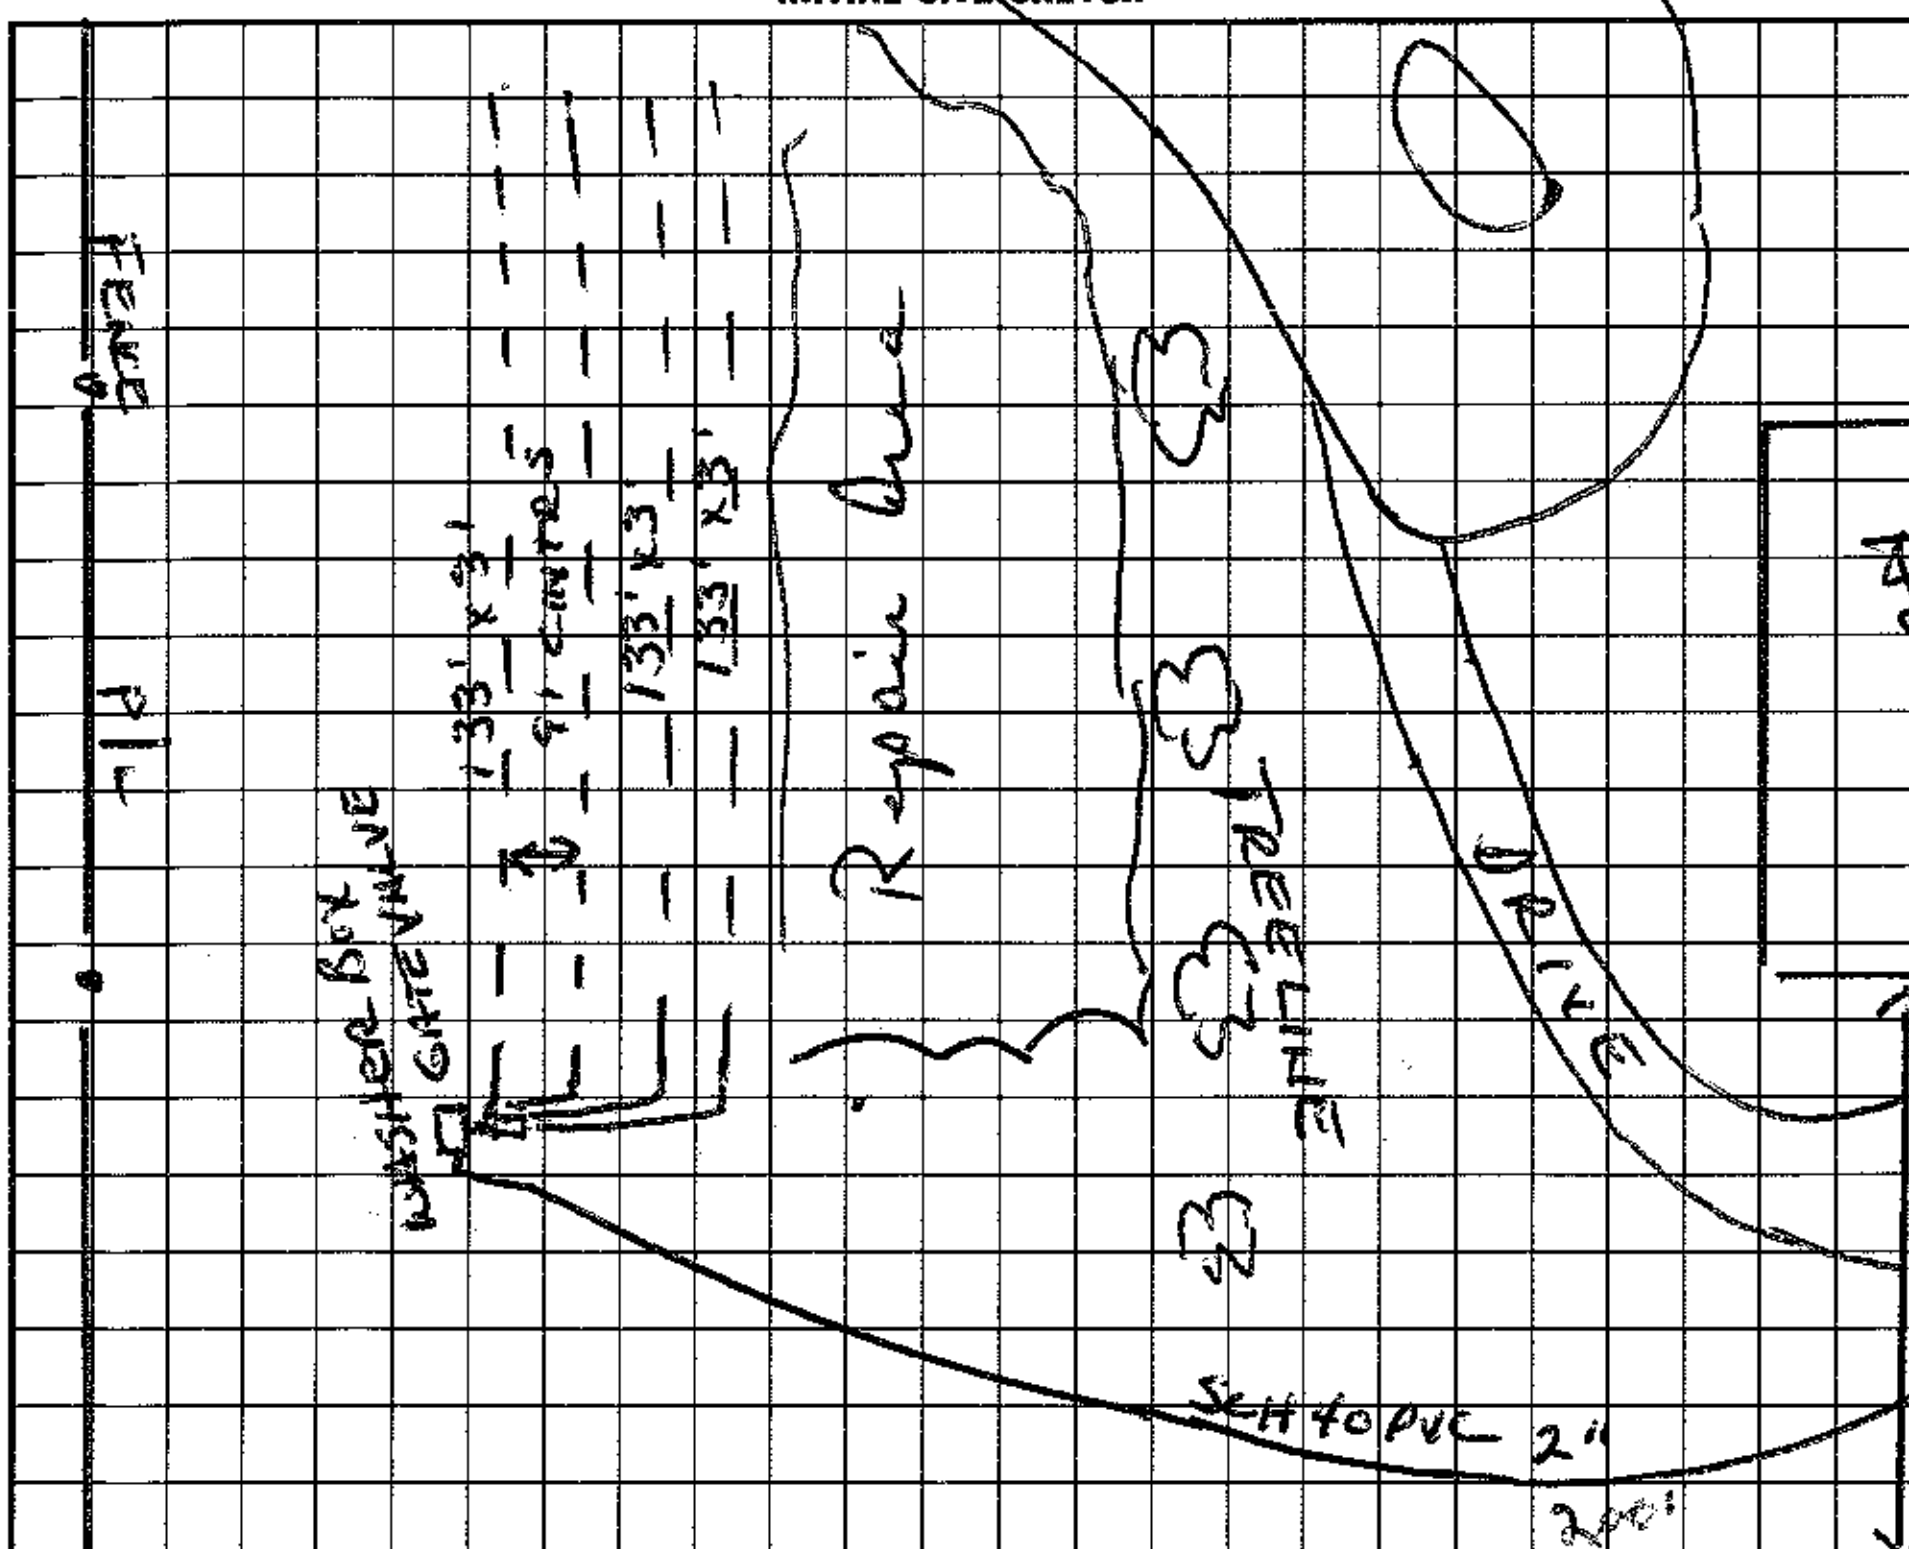

AS BUILT SKETCH

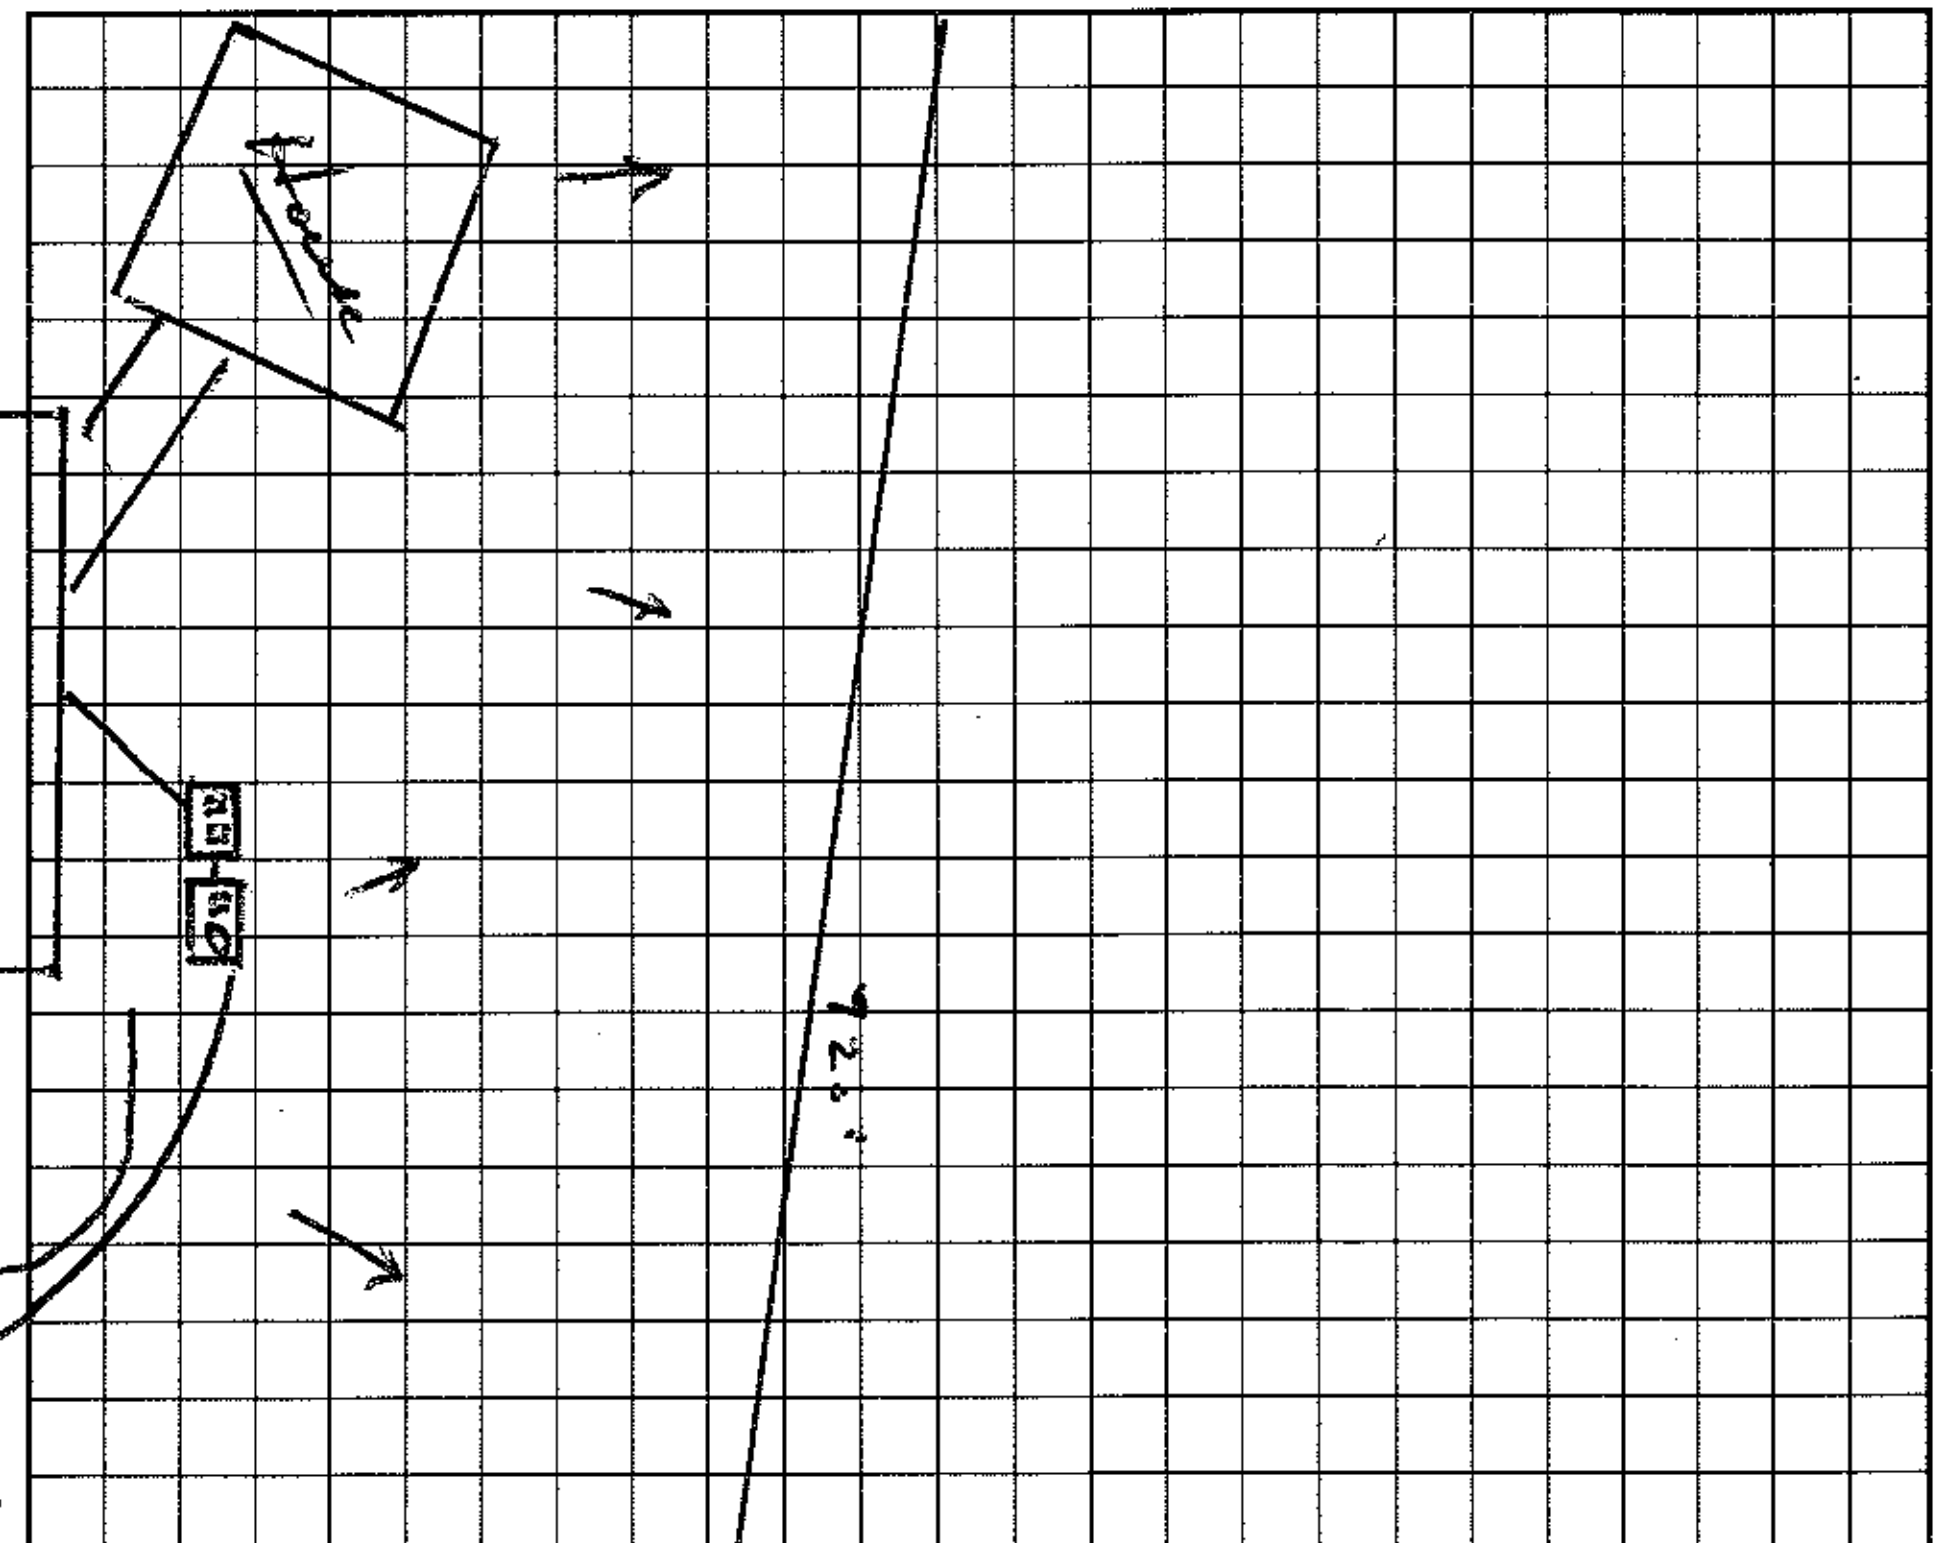

I understand that this permit can be suspended or revoked if any false information is supplied toward securing the permit/any unauthorized changes are made to the site/any unauthorized changes are made in the installation of the system. Improvement Permit is valid for 60 months from date of issuance.

Signed: Harold J. Blevins

Installed by: Sigmon Environmental Service

Improvement Permit by: Wesley Sparks RS. date 5/10/95

Certificate of Completion by: ______ date ______

Existing System Inspection by: ______ date ______

Operation Permit by: Wesley Sparks RS. date 11/22/96

HEALTH DEPT. COPY: WHITE INSPECTION COPY (FINAL): GREEN OWNER COPY (FINAL): YELLOW INSPECTION COPY (INITIAL): PINK OWNER COPY (INITIAL): GOLD