IREDELL COUNTY HEALTH DEPARTMENT

4679396365 3;30

STATESVILLE 704-878-5305 MOORESVILLE 704-664-5281

IMPROVEMENT PERMIT / CERTIFICATE OF COMPLETION / OPERATION PERMIT / EXISTING SYSTEM INSPECTION

PROPERTY DESCRIPTION NO. 19359 DATE 9/13/94 TAX MAP NO. 4H-2-A-9 Watershed: ☒ Yes ☐ No

OWNER OR CONTRACTOR James Workman (Greg Hoglerton) PHONE: Business _____ Home 664-2104

ADDRESS Hunter Woods Mooresville, NC,

LOCATION Confederate Rd, (R) off Tupelo Trl Rd. w 1/2 mile on (R) at longleaf trees 360AWS

SUBDIVISION Tupelo Trails BLOCK / SECTION _____ LOT 9 LOT AREA 3.5AC SITE CLASS. P DESIGN FLOW ~~480~~ L.T.A.R. ~~3~~ 4 AWS

Septic Tank: 1000 Gallons; STB 194 Date 6/13/96 ☒ New System ☐ Repair System Type: I, (II) III, IV, V, VI ☒ House/Mod. Home No. Bedrooms ~~4~~ 3 Water Supply: ☒ Individual

Pump Tank: _____ Gallons; PT _____ Date _____ System Description: CONV - FLOWDIVIDER - DISTRIB ☐ Mobile Home No. Bathrooms 2.5 ☐ Community

Pump Make: _____ Model 1200AWS Serial No. 400 AWS Repair System Description: _____ ☐ Business No. Employees _____ ☐ Public

Nitrification Field: No Fields 1 Square Feet ~~480~~ Linear Feet ~~533~~ Maintenance Agreement Required: ☐ Yes ☒ No ☐ Other _____


No Lines ~~4~~ 3 Trench Width 36" Max Trench Bottom Depth 36" Gravel Depth 12" ☐ Slab ☒ Crawl Space ☐ Basement w/plumbing ☐ Basement wo/plumbing

Comments:


Comments:

8/22/96 Changed to 3BORm, PLAN REVIEWED HWS

INITIAL SITE SKETCH

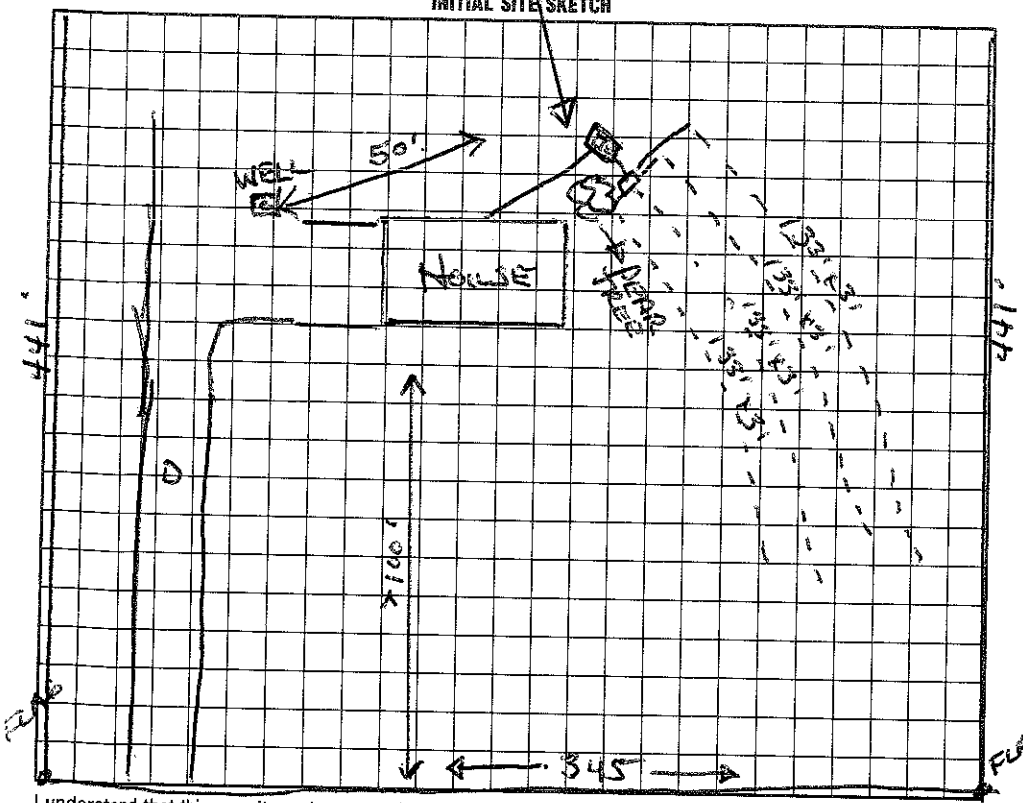

AS BUILT SKETCH

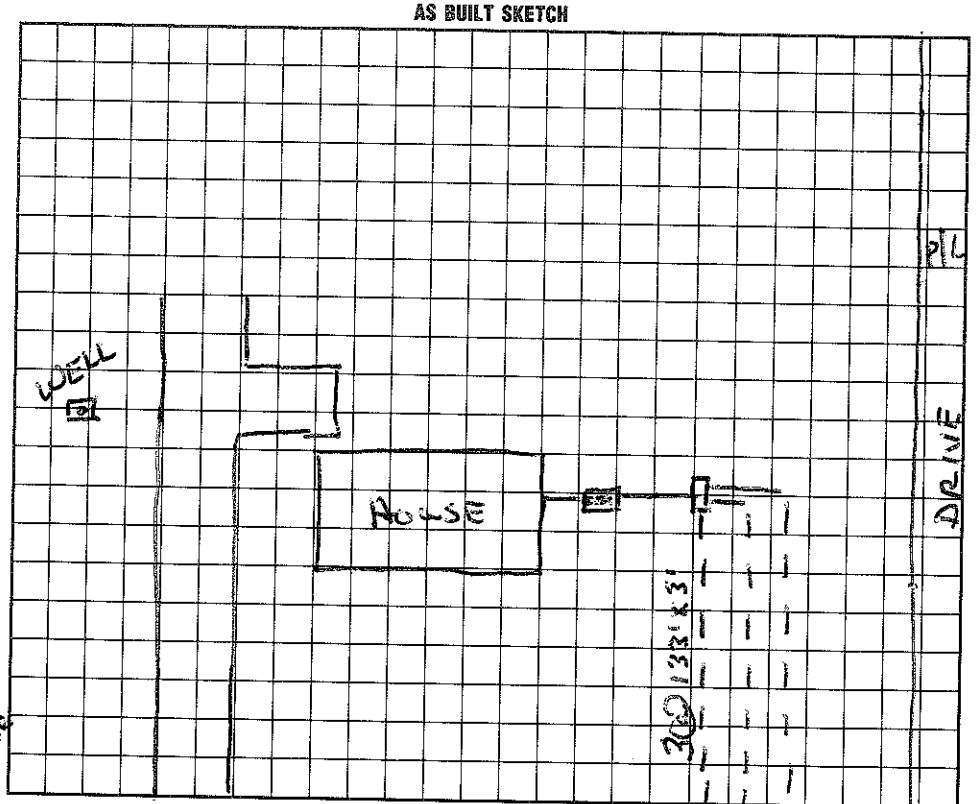

I understand that this permit can be suspended or revoked if any false information is supplied toward securing the permit/any unauthorized changes are made to the site/any unauthorized changes are made in the installation of the system. Improvement Permit is valid for ~~60~~ months from date of issuance. CONFEDERATE RD.

Signed: Greg Hoglerton

Improvement Permit by: Wesley Sparks RS. date 9/13/94

Existing System Inspection by: _____ date _____

Installed by: Lang Beam

Certificate of Completion by: _____ date _____

Operation Permit by: Wesley Sparks RS. date 8/27/96

HEALTH DEPT. COPY: WHITE INSPECTION COPY (FINAL): GREEN OWNER COPY (FINAL): YELLOW INSPECTION COPY (INITIAL): PINK OWNER COPY (INITIAL): GOLD